

SIMPSON  
616  
6-12-74

MISSISSIPPI  
BOARD OF WATER COMMISSIONERS  
416 North State Street  
Jackson, Mississippi 39201 **CODED**

WATER WELL DRILLERS LOG

6-12-1974 W. K. Barnes Waterworks Simpson  
date well completed firm name county well located

LANDOWNER: Bethlehem Church  
Rt. 1  
Pinola Miss.  
(mailing address)  
WELL LOCATION: (IN) (2E)  
sec. 34 T 5 R 2E  
4 miles W of Pinola  
(distance) (direction) (nearest town)  
WELL PURPOSE: Church use  
(home, irrigation, municipal, industrial)

description of formations encountered	from	to
Red Clay	0	6
Yellow Clay	6	20
Shale	20	65
Blue Clay	65	86
Rock	86	91
Blue Clay	91	150
Rock	150	160
Fine Sand	160	165
Blue Clay	165	340
Rock	340	385
Blue Sand	385	407


WELL COMPLETION DATA:  
(1) diameter (inches) 2  
(2) total depth (feet) 407  
(3) static water level (feet) 30 below above top of ground.  
(4) casing Galv. (material) (depth) \_\_\_\_\_  
(size) If telescope see back.  
(5) screen 8 (length) (depth to top) \_\_\_\_\_  
06 (size) Stainless (material)  
(6) pump L-H.P. (HP) 10 (yield gpm)  
Elec. (type power)  
(7) electric log no (yes or no)  
(organization running log) \_\_\_\_\_  
(8) how well bottom plugged Wash valve

fract. Very Hard  
**CODED**  
**RECEIVED**  
JUL 15 1974

DRILLERS REMARKS:

If well telescopes please sketch and show depths.

GROUND LEVEL

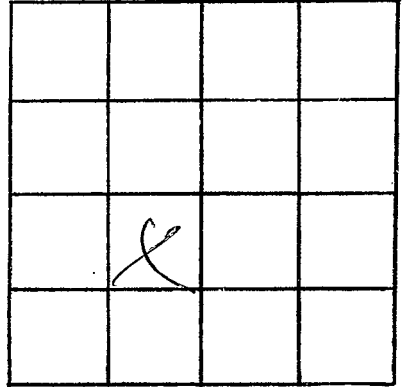

SECTION 34

Please indicate well location X.

ADDITIONAL INFORMATION

If more than one screen,  
show locations of each on sketch.