

SIMPSON
G17
1-22-75

MISSISSIPPI
BOARD OF WATER COMMISSIONERS
416 North State Street
Jackson, Mississippi 39201

CODED

WATER WELL DRILLERS LOG

Jan 22/75 19 75 R. E. Simpson Simpson
date well completed firm name county well located

LANDOWNER:
S. M. Walker Jr.
(mailing address)

description of formations encountered	from	to
<u>Top soil</u>	<u>0</u>	<u>5</u>
<u>Sand clay</u>	<u>5-40</u>	
<u>Blue clay</u>	<u>40</u>	<u>240</u>
<u>sand</u>	<u>260</u>	<u>290</u>

WELL LOCATION:
sec. 27 T N R. 2 E
S W
7 miles W of Disola
(distance) (direction) (nearest town)

WELL PURPOSE: Home
(home, irrigation, municipal, industrial)

- WELL COMPLETION DATA:
- (1) diameter (inches) 2 1/2"
 - (2) total depth (feet) 290'
 - (3) static water level (feet) 84 ^{below}/_{above} top of ground.
 - (4) casing Plastic 280'
(material) (depth)
2"
(size) If telescope see back.
 - (5) screen 10', 280'
(length) (depth to top)
.008, Plastic
(size) (material)
 - (6) pump his pump
(HP) (yield gpm)
Jack
(type power)
 - (7) electric log no
(yes or no)

CODED

(organization running log)

(8) how well bottom plugged blacked


RECEIVED

APR 21 1975

DRILLERS REMARKS:

If well telescopes please
sketch and show depths.

GROUND LEVEL

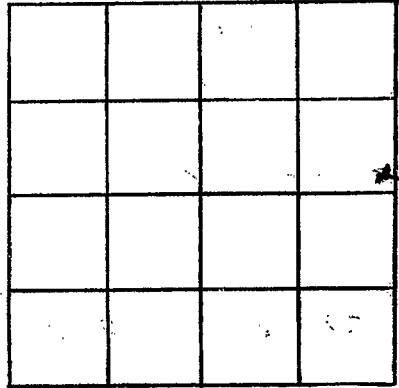

SECTION 27

Please indicate well location X.

ADDITIONAL INFORMATION

If more than one screen,
show locations of each on sketch.