

Simpson
G-18

MISSISSIPPI
BOARD OF WATER COMMISSIONERS
416 North State Street
Jackson, Mississippi 39201

CODED

WATER WELL DRILLERS LOG

7-1 1985 Guinn Well See Simpson
date well completed firm name county well located

LANDOWNER:	description of formations encountered	from	to
<u>L.V. Robinson</u>			
(mailing address)	<u>SAND</u>	<u>150</u>	<u>170</u>
WELL LOCATION:			
sec. <u>9</u> T <u>1</u> N R <u>2</u> E			
(distance) miles _____ of _____ (direction) (nearest town)			
WELL PURPOSE: (home, irrigation, municipal, industrial)			
WELL COMPLETION DATA:			
(1) diameter (inches) <u>4"</u>			
(2) total depth (feet) <u>170</u>			
(3) static water level (feet) <u>60</u> below top of ground.			
(4) casing <u>PVC</u> , <u>150'</u> (material) (depth)			
<u>4"</u> (size) If telescope see back.			
(5) screen <u>20'</u> , <u>150'</u> (length) (depth to top)			
<u>4"</u> , <u>PVC</u> (size) (material)			
(6) pump <u>1</u> , <u>10</u> (HP) (yield gpm)			
(type power)			
(7) electric log _____ (yes or no) <u>MGS</u> (organization running log)			
(8) how well bottom plugged <u>BCV</u>			
DRILLERS REMARKS:			

CODED


RECEIVED

JUN 25 1986

Department of Natural Resources
Bureau of Land & Water Resources

If well telescopes please sketch and show depths.

GROUND LEVEL

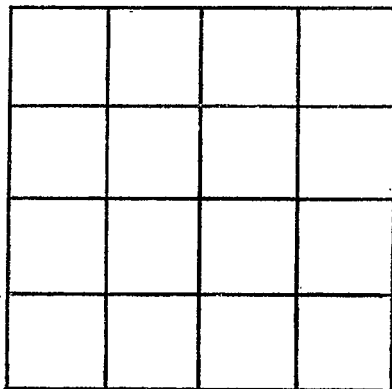

SECTION _____

Please indicate well location X.

ADDITIONAL INFORMATION

If more than one screen,
show locations of each on sketch.