

SIMPSON  
 G19  
 8-16-77  
 F log # 187  
 4-16

MISSISSIPPI  
 BOARD OF WATER COMMISSIONERS  
 416 North State Street  
 Jackson, Mississippi 39201

CODED

WATER WELL DRILLERS LOG

1977 JACK GUINN firm name SIMPSON county well located

LANDOWNER:  
 LAFALETTE CRUMP  
 (mailing address)


WELL LOCATION:  
 sec. 32, T. 1 N. R. 2 E. S. 8  
 (distance) miles (direction) of (nearest town)

WELL PURPOSE:  
 (home, irrigation, municipal, industrial)

- WELL COMPLETION DATA:
- (1) diameter (inches) 2"
  - (2) total depth (feet) 345
  - (3) static water level (feet) 20' below above top of ground.
  - (4) casing PVC, 325 (material) (depth)
  - 2" (size) if telescope see back.
  - (5) screen 20" 325 (length) (depth to top)
  - 2" PVC (size) (material)
  - (6) pump 1/2 40 (HP) (yield gpm)
  - MPC (type power)
  - (7) electric log yes (yes or no)
  - MCS (organization running log)
  - (8) how well bottom plugged BWW

description of formations encountered	from	to
GRAVEL	0	30
CLAY	30	60
SANDY SHALE	60	80
CLAY	80	140
SAND	140	160
CLAY	160	200
SAND	200	240
CLAY	240	310
SAND	310	390


CODED

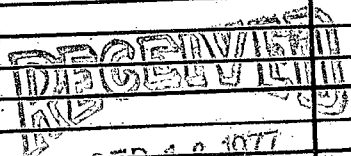

DRILLERS REMARKS:

If well telescopes please sketch and show depths.

GROUND LEVEL

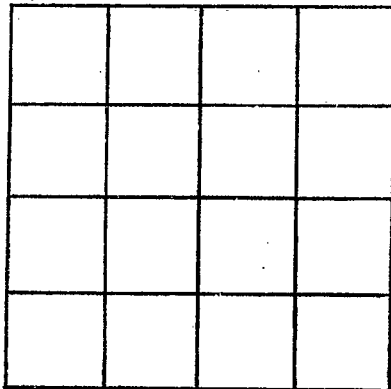

SECTION \_\_\_\_\_

Please indicate well location X.

ADDITIONAL INFORMATION

A series of horizontal lines providing space for additional information.

If more than one screen, show locations of each on sketch.