

SIMPSON
 820
 9-2-77
 Log # 190

MISSISSIPPI
 BOARD OF WATER COMMISSIONERS
 416 North State Street
 Jackson, Mississippi 39201

CODED

WATER WELL DRILLERS LOG

9-2-77 date well completed 19 Brown Water Well Co firm name SIMPSON county well located

LANDOWNER:
B Brown, C.R.
 (mailing address)

WELL LOCATION:
 sec. 23 T. 1 N. R. 2 E
 (distance) (direction) (nearest town)

WELL PURPOSE:
 (home, irrigation, municipal, industrial)

WELL COMPLETION DATA:

(1) diameter (inches) 4"

(2) total depth (feet) 440

(3) static water level (feet) 100 below above top of ground.

(4) casing PVC 440
 (material) (depth)

4" if telescope see back.
 (size)

(5) screen 20' 420
 (length) (depth to top)

4" PVC
 (size) (material)

(6) pump 1/2 15
 (HP) (yield gpm)

(type power)

(7) electric log yes (yes-or-no)
M&S
 (organization running log)

(8) how well bottom plugged 1500

description of formations encountered	from	to
SAND	0	100
CLAY	100	150
SAND	150	155
CLAY	155	420
SAND	420	440

CODED


RECEIVED

NOV 16 1977

DRILLERS REMARKS:

If well telescopes please sketch and show depths.

GROUND LEVEL

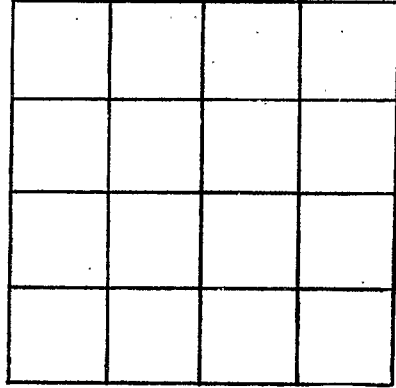

SECTION _____

Please indicate well location X.

ADDITIONAL INFORMATION

If more than one screen, show locations of each on sketch.