

SIMPSON

~~PAID~~
~~777~~ 522
 2-12-79

MISSISSIPPI
 BOARD OF WATER COMMISSIONERS
 416 North State Street
 Jackson, Mississippi 39201

CODED

WATER WELL DRILLERS LOG

2-12-79 date well completed
 1979 Gunn water well Simpson firm name
 county well located

LANDOWNER:
 L. C. Walker
 (mailing address)

description of formations encountered	from	to
CLAY	0	4
sand & gravel	4	55
CLAY	55	370
SAND	370	396

WELL LOCATION:
 sec. 36 T. 1 N R. 2 E
 (distance) miles (direction) of (nearest town)

WELL PURPOSE:
 (home, irrigation, municipal, industrial)

CODED

WELL COMPLETION DATA:

(1) diameter (inches) 2 1/4

(2) total depth (feet) 396

(3) static water level (feet) 25 (below top of ground)

(4) casing (material) PVC (depth) 376
 2 (size) if telescope see back.

(5) screen 20 (length) 374 (depth to top)
 2 (size) BOC (material)

(6) pump 2 (HP) 5 (yield gpm)

(type power)

(7) electric log (yes or no) MFS (organization running log)

(8) how well bottom plugged BUC

Miss. Board of Water Comm


APR 25 1979

DRILLERS REMARKS:

RECEIVED

If well telescopes please sketch and show depths.

GROUND LEVEL

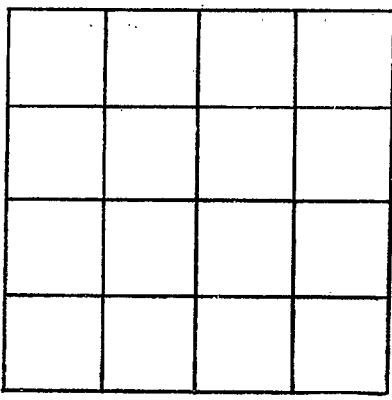

SECTION _____

Please indicate well location X.

ADDITIONAL INFORMATION

A series of 20 horizontal lines for recording additional information.

If more than one screen, show locations of each on sketch.