

MISSISSIPPI DEPARTMENT OF NATURAL RESOURCES

Bureau of Land and Water Resources

Southport Mall

P.O. Box 10631

Jackson, Mississippi 39209

WATER WELL DRILLERS LOG

CODED

SIMPSON
G23
5-10-79
Elog # 228

G

5-19-79

Jack D. Dunn

Simpson

date well completed

firm name

county well located

LANDOWNER:

Carolyn Taylor

(mailing address)

WELL LOCATION:

sec. 23 T 1 N R 2 E

(distance) miles (direction) of (nearest town)

WELL PURPOSE: Home
(home, irrigation, municipal, industrial)

WELL COMPLETION DATA:

- (1) diameter (inches) 2"
- (2) total depth (feet) 284
- (3) static water level (feet) 40 below top of ground.
- (4) casing PVC 264 (material), (depth)
- (size) 2 if telescope see back.
- (5) screen 20 264 (length), (depth to top)
- (size) 2 PVC (material)
- (6) pump 1 8 (HP), (yield gpm)
- (type power)
- (7) electric log yes (yes or no)
- MGS (organization running log)

(8) how well bottom plugged

DRILLERS REMARKS:

description of formations encountered

from

to

Gravel	0	100
CLAY	100	160
Gravel	160	190
Gravel	190	230
Sandy	230	264
CLAY	264	284
SAND	264	284

CODED


DEPT. OF NATURAL RESOURCES
BUREAU OF LAND & WATER RESOURCES

DEC 9 1980

RECEIVED

If well telescopes please sketch and show depths.

GROUND LEVEL

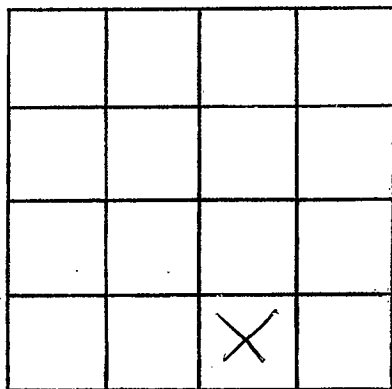

SECTION 23

Please indicate well location X.

ADDITIONAL INFORMATION

If more than one screen,
show locations of each on sketch.