

SIMPSON  
 524  
 6-6-79

MISSISSIPPI  
 BOARD OF WATER COMMISSIONERS  
 416 North State Street  
 Jackson, Mississippi 39201

CODED

WATER WELL DRILLERS LOG

6-6-1979 Burns Water Wells Inc  
 date well completed firm name county well located  
SIMPSON

LANDOWNER:  
Jessie Funches  
Funches  
 (mailing address)

description of formations encountered	from	to
Sand	0	48
Sand & clay str.	40	160

WELL LOCATION:  
 sec. 30 T 1 N R 2 E  
 S W  
 (distance) miles (direction) of (nearest town)

CODED

WELL PURPOSE:  
 (home, irrigation, municipal, industrial)

WELL COMPLETION DATA:

(1) diameter (inches) 2 1/2

(2) total depth (feet) 190

(3) static water level (feet) 15 below above top of ground.

(4) casing pvc 190  
 (material) (depth)  
2 1/2 (size) If telescope see back.

(5) screen 20 190  
 (length) (depth to top)  
2 1/2 pvc  
 (size) (material)

(6) pump 1 10  
 (HP) (yield gpm)

(type power)

(7) electric log \_\_\_\_\_  
 (yes or no)  
MOS  
 (organization running log)

(8) how well bottom plugged BAV


Handwritten notes and signatures in the right column, including a signature and date "10-3-79".

DRILLERS REMARKS:

Blank space for drillers remarks.

If well telescopes please sketch and show depths.

GROUND LEVEL

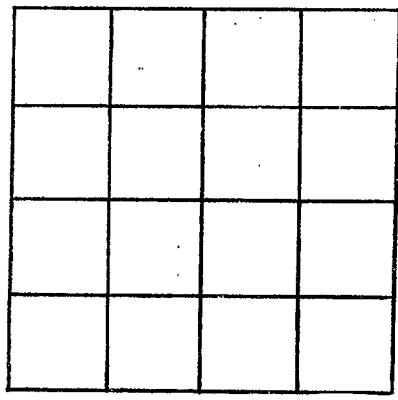

SECTION \_\_\_\_\_

Please indicate well location X.

ADDITIONAL INFORMATION

A series of horizontal lines for recording additional information.

If more than one screen, show locations of each on sketch.