

MISSISSIPPI DEPARTMENT OF NATURAL RESOURCES

Bureau of Land and Water Resources

Southport Mall

P.O. Box 10631

Jackson, Mississippi 39209

WATER WELL DRILLERS LOG

CODED

SIMPSON
 W 25
 6-15-79
 Flg # 231

G

date well completed 6-19-79 firm name Jack D. Quinn county well located Simpson

LANDOWNER:
Lewis Carter

description of formations encountered	from	to
Sand	0	40
CLAY	40	60
Sand	60	90
CLAY	90	120
Sand	120	150
CLAY	150	340
Sand	340	380

(mailing address)

WELL LOCATION:
 sec. 19 T. 1 N. R. 2 E

WELL PURPOSE: Home
 (home, irrigation, municipal, industrial)

WELL COMPLETION DATA:

- (1) diameter (inches) 2"
- (2) total depth (feet) 380
- (3) static water level (feet) 6 below top of ground.
- (4) casing PVC 360,
 (material) (depth)
2 if telescope see back.
 (size)
- (5) screen 20 360
 (length) (depth to top)
2 PVC
 (size) (material)
- (6) pump 1 40
 (HP) (yield gpm)
 (type power)
- (7) electric log yes
 (yes or no)
MGS
 (organization running log)
- (8) how well bottom plugged

CODED

DEPT. OF NATURAL RESOURCES
 BUREAU OF LAND & WATER RESOURCES


DEC - 9 1980

RECEIVED

DRILLERS REMARKS:

If well telescopes please sketch and show depths.

GROUND LEVEL

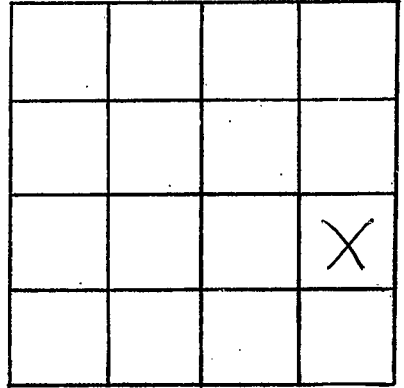

SECTION 19

Please indicate well location X.

ADDITIONAL INFORMATION

If more than one screen,
show locations of each on sketch.