

SIMPSON
528
5-11-82

MISSISSIPPI
BOARD OF WATER COMMISSIONERS
416 North State Street
Jackson, Mississippi 39201

CODED ✓

WATER WELL DRILLERS LOG

5-11 19 82 date well completed
Gunn Well SA Simpson firm name
Simpson county well located

LANDOWNER:	description of formations encountered	from	to
C. W. BARLOW (mailing address)	CLAY Sand	0 360	360 390
WELL LOCATION:			
sec. 13 T 8 N R 2 E (distance) miles (direction) of (nearest town)			
WELL PURPOSE: (home, irrigation, municipal, industrial)			
WELL COMPLETION DATA:			
(1) diameter (inches) 4 1/2			
(2) total depth (feet) 370			
(3) static water level (feet) 80 below top of ground.			
(4) casing PVC 370 (material), (depth) 4 1/2			
(size) if telescope see back.			
(5) screen 20 370 (length), (depth to top)			
(size) 4 1/2 (material) PVC			
(6) pump 1 15 (HP), (yield gpm)			
(type power)			
(7) electric log (yes or no)			
(organization running log)			
(8) how well bottom plugged BOW			
DRILLERS REMARKS:			

CODE


DEPT. OF NATURAL RESOURCES
BUREAU OF LAND & WATER RESOURCES

NOV 30 1982

RECEIVED

If well telescopes please sketch and show depths.

GROUND LEVEL

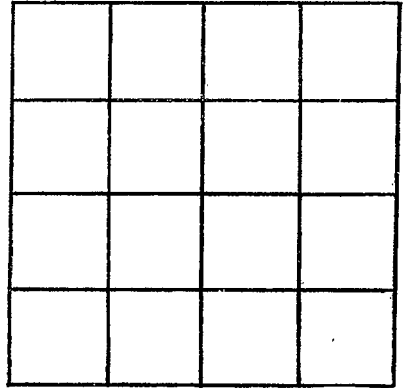

SECTION _____

Please indicate well location X.

ADDITIONAL INFORMATION

If more than one screen,
show locations of each on sketch.