

SIMPSON
 530
 8-17-82
 Log # 290

MISSISSIPPI
 BOARD OF WATER COMMISSIONERS
 416 North State Street
 Jackson, Mississippi 39201

CODED

WATER WELL DRILLERS LOG

8-17-82 date well completed
 98 Gump's well ser firm name
 Simpson county well located

LANDOWNER:	description of formations encountered	from	to
Eugene Taylor	S and	0	40
(mailing address)	C&A	40	390
WELL LOCATION:	S and	390	410
sec. 25 T 1 N R 2 E			
(distance) miles (direction) of (nearest town)			
WELL PURPOSE: (home, irrigation, municipal, industrial)			
WELL COMPLETION DATA:			
(1) diameter (inches) 2"			
(2) total depth (feet) 410			
(3) static water level (feet) 50 below top of ground.			
(4) casing PVC 390 (material) (depth)			
2" if telescope see back. (size)			
(5) screen 20 390 (length) (depth to top)			
2" PVC (size) (material)			
(6) pump 1 5 (HP) (yield gpm)			
(type power)			
(7) electric log (yes or no)			
(organization running log)			
(8) how well bottom plugged B&V			
DRILLERS REMARKS:			

CODED


DEPT. OF NATURAL RESOURCES
 BUREAU OF LAND & WATER RESOURCES

NOV 30 1982

RECEIVED

If well telescopes please sketch and show depths.

GROUND LEVEL

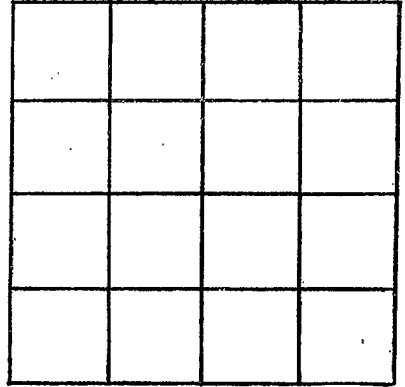

SECTION _____

Please indicate well location X.

ADDITIONAL INFORMATION

If more than one screen,
show locations of each on sketch.