

Simmons  
G31

MISSISSIPPI  
BOARD OF WATER COMMISSIONERS  
416 North State Street  
Jackson, Mississippi 39201

CODED.

WATER WELL DRILLERS LOG

1-24 1986 Sumner Well Co Sumner  
date well completed firm name county well located

LANDOWNER:	description of formations encountered	from	to
<u>CARL SMITH</u>			
(mailing address)	<u>CLAY</u>	<u>40</u>	<u>160</u>
	<u>SAND</u>	<u>160</u>	<u>180</u>
WELL LOCATION:			
sec. <u>24</u> T <u>1</u> N R <u>1</u> E <u>S</u> <u>W</u>			
(distance) miles _____ of _____ (direction) (nearest town)			
WELL PURPOSE: (home, irrigation, municipal, industrial)			
WELL COMPLETION DATA:			
(1) diameter (inches) <u>2 1/2</u>			
(2) total depth (feet) <u>180</u>			
(3) static water level (feet) <u>50</u> below top of ground. above			
(4) casing <u>PVC</u> <u>160</u> (material) (depth)			
<u>2 1/2</u> (size) if telescope see back.			
(5) screen <u>20'</u> <u>160</u> (length) (depth to top)			
<u>2 1/2</u> <u>PVC</u> (size) (material)			
(6) pump _____ (HP) (yield gpm)			
(type power)			
(7) electric log _____ (yes or no)			
<u>MFS</u> (organization running log)			
(8) how well bottom plugged <u>BWD</u>			
DRILLERS REMARKS: <u>Did NOT set PUMP</u>			


CODED

RECEIVED  
JUN 25 1986

Department of Natural Resources  
Bureau of Land & Water Resources

If well telescopes please sketch and show depths.

GROUND LEVEL

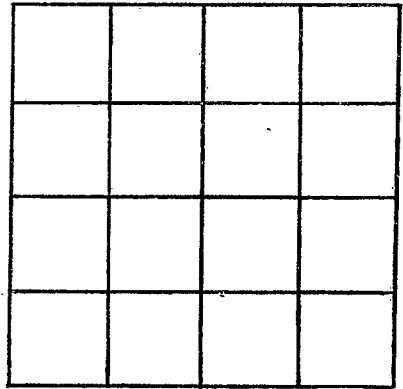

SECTION \_\_\_\_\_

Please indicate well location X.

ADDITIONAL INFORMATION

If more than one screen, show locations of each on sketch.