

C. P. CLARK

MISSISSIPPI WATER WELL DRILLING  
BOARD OF WATER COMMISSIONERS ROUTE 2  
416 North State Street LAUREL, MISS. 39440  
137 Jackson, Mississippi 39201

Simpson  
G 2000  
5-12-77

WATER WELL DRILLERS LOG

5/12 1977 date well completed  
C.P. Clark firm name  
Simpson county well located

LANDOWNER: Leroy M. Schutesh  
Pt 1 Baf 106  
Picoula, Miss.  
(mailing address)

WELL LOCATION:  
sec. 34 T. 1 N. R. 2 E  
S W  
1/2 miles S.W. of Union  
(distance) (direction) (nearest town)

WELL PURPOSE: Home  
(home, irrigation, municipal, industrial)

WELL COMPLETION DATA:  
(1) diameter (inches) 2  
(2) total depth (feet) 326  
(3) static water level (feet) 10 below top of ground.  
(4) casing Galvalume 315 (material) (depth)  
(size) If telescope see back.  
(5) screen 11 315 (length) (depth to top)  
1/4 S.S. 006 (size) (material)  
(6) pump (25 w in) (HP) (yield gpm)  
1100 (type power)  
(7) electric log no (yes or no)  
(organization running log)  
(8) how well bottom plugged B.W.U

description of formations encountered	from	to
Clay	0	15
Blue Clay	15	86
fine Sand	86	89
Clay Sand Strata	89	126
fine Sand	126	136
Hard Sticky Clay	136	310
Medium Sand	310	326
Hard Clay	326	331


DRILLERS REMARKS: Customer to set his own Section Shallow well Pump

RECEIVED  
MAY 16 1977

MISS. Bd. OF WATER COMMISSIONERS

If well telescopes please sketch and show depths.

GROUND LEVEL

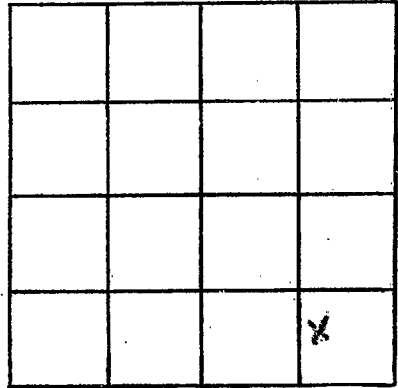

SECTION 34

Please indicate well location X.

ADDITIONAL INFORMATION

Lined area for additional information.

If more than one screen, show locations of each on sketch.