

SIMPSON  
 G 2001  
 11-09-78

MISSISSIPPI  
 BOARD OF WATER COMMISSIONERS  
 416 North State Street  
 Jackson, Mississippi 39201

WATER WELL DRILLERS LOG

*Simpson*  
~~Griffith~~

11-9  
 date well completed

1978 TOM GRIFFITH  
 PLUMBING & WELL SERVICE, INC.  
 320 MAYSON AVE.

county well located

LANDOWNER:  
*Donice Williams*  
*P.O. 274 - Harrisville*  
 (mailing address) *Miss.*

description of fomations encountered	from	to
<i>Top Soil</i>	0	2
<i>Shale</i>	2	14
<i>Sandstone</i>	14	21
<i>Red S.</i>	21	26
<i>Shale</i>	26	27
<i>Shale &amp; Sand</i>	27	196
<i>Chalk</i>	193	305
<i>Sand &amp; Red</i>	305	389
<i>Sand</i>	389	405

WELL LOCATION:  
 sec. *4* T. *1* N. *2* E  
 S. W.  
*1* miles (distance) *S* (direction) *Harrisville* (nearest town)

WELL PURPOSE: *Home*  
 (home, irrigation, municipal, industrial)

WELL COMPLETION DATA:

(1) diameter (inches) *4"*

(2) total depth (feet) *405 ft*

(3) static water level (feet) *230 ft* below top of ground.

(4) casing *plastic* (material) *385 ft* (depth)  
*4"* (size) if telescope see back.

(5) screen *20 ft* (length) *385* (depth to top)  
*4"* (size) *plastic* (material)

(6) pump *3/4* (HP) *10* (yield gpm)  
*Electric* (type power)

(7) electric log *no* (yes or no)

(organization running log)

(8) how well bottom plugged *Back wash valve*


DRILLERS REMARKS:

RECEIVED  
 FEB - 1 1978

MISS. BD. OF WATER COMMISSIONERS

If well telescopes please sketch and show depths.

GROUND LEVEL

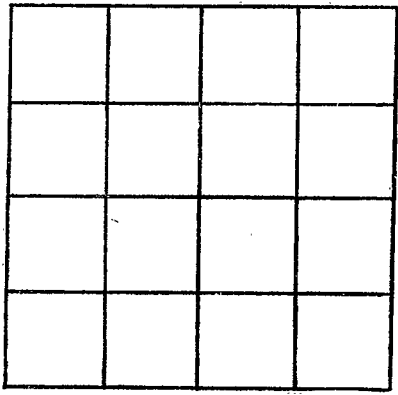

SECTION \_\_\_\_\_

Please indicate well location X.

ADDITIONAL INFORMATION

If more than one screen, show locations of each on sketch.