

SIMPSON
G 2003
8-16-78

**MISSISSIPPI
BOARD OF WATER COMMISSIONERS**
416 North State Street
Jackson, Mississippi 39201

WATER WELL DRILLERS LOG

Aug-16-78 19 GUINN WATER WELL SERV SIMPSON
 date well completed firm name county well located

LANDOWNER:
GILLIS

(mailing address)

WELL LOCATION:
 sec. 34 T 1 N R 21 E
34 W
 miles of
 (distance) (direction) (nearest town)

WELL PURPOSE:
(home, irrigation, municipal, industrial)

WELL COMPLETION DATA:

(1) diameter (inches) 4"

(2) total depth (feet) 380

(3) static water level (feet) 50 below top of ground.

(4) casing PVC, 360
 (material) (depth)

4 if telescope see back.
 (size)

(5) screen 20, 360
 (length) (depth to top)

2
 (size) PVC
 (material)

(6) pump 3/4, 15
 (HP) (yield gpm)

(type power)

(7) electric log N
 (yes or no)

(organization running log)

(8) how well bottom plugged BU V

description of formations encountered	from	to
CLAY	0	60
CLAY	60	100
CLAY	100	150
CLAY	150	360
SAND	360	380

DRILLERS REMARKS:


RECEIVED

DEC 13 1978

MISS. Bd. OF WATER COMMISSIONERS

If well telescopes please sketch and show depths.

GROUND LEVEL

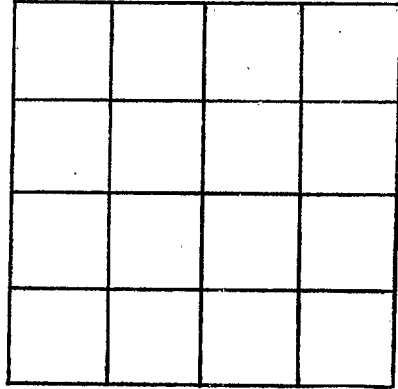

SECTION _____

Please indicate well location X.

ADDITIONAL INFORMATION

If more than one screen, show locations of each on sketch.