

SIMPSON
 G 2003
 10-16-78

MISSISSIPPI
 BOARD OF WATER COMMISSIONERS
 416 North State Street
 Jackson, Mississippi 39201

WATER WELL DRILLERS LOG

10-16-78 19 *Grimm Waterwell Service Simpson*
 date well completed firm name county well located

LANDOWNER:
Capeland
 (mailing address)
 WELL LOCATION:
 sec. *34* T. *8N* R. *2E*
 miles of
 (distance) (direction) (nearest town)

description of formations encountered	from	to
<i>CLAY</i>	<i>0</i>	<i>255</i>
<i>SAND</i>	<i>255</i>	<i>270</i>
<i>CLAY</i>	<i>270</i>	<i>380</i>
<i>SAND</i>	<i>380</i>	<i>400</i>

WELL PURPOSE:
 (home, irrigation, municipal, industrial)

WELL COMPLETION DATA:

(1) diameter (inches) *9*

(2) total depth (feet) *420*

(3) static water level (feet) *40* below above top of ground.

(4) casing *PVC* *400*
 (material) (depth)

9 if telescope see back.
 (size)

(5) screen *20* *400*
 (length) (depth to top)

9 *PVC*
 (size) (material)

(6) pump *1* *10*
 (HP) (yield gpm)

(type power)

(7) electric log *NO*
 (yes or no)

(organization running log)


(8) how well bottom plugged *BSW*

DRILLERS REMARKS:

RECEIVED
 DEC 13 1978

If well telescopes please sketch and show depths.

GROUND LEVEL

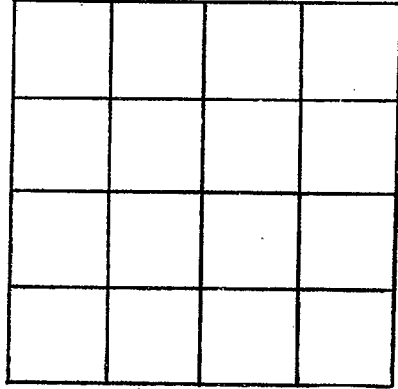

SECTION _____

Please indicate well location X:

ADDITIONAL INFORMATION

If more than one screen, show locations of each on sketch.