

SIMPSON
6 2004
1-30-80

MISSISSIPPI
BOARD OF WATER COMMISSIONERS
416 North State Street
Jackson, Mississippi 39201

WATER WELL DRILLERS LOG

1-30-1980 date well completed Roy V. WEST Well Drig. firm name Simpson county well located

LANDOWNER: Rownie Smith
Rt 3 Mendehall
(mailing address)

description of formations encountered	from	to
CLAY	0	12
SHALE	12	36

WELL LOCATION:
sec 34 T 1 N R 2 E
S W
20 miles W of Pindola
(distance) (direction) (nearest town)

WELL PURPOSE: HOME
(home, irrigation, municipal, industrial)

- WELL COMPLETION DATA:
- (1) diameter (inches) 2"
 - (2) total depth (feet) 36'
 - (3) static water level (feet) 19' below above top of ground.
 - (4) casing PVC 31'
(material) (depth)
(size) If telescope see back.
 - (5) screen 5' 34'
(length) (depth to top)
1 1/2" STAINLESS STEEL
(size) (material)
 - (6) pump 1 6
(HP) (yield gpm)
REA
(type power)
 - (7) electric log NO
(yes or no)
(organization running log)
 - (8) how well bottom plugged WASH WAVE

DRILLERS REMARKS:


DEPT. OF NATURAL RESOURCES
BUREAU OF LAND & WATER RESOURCES

MAR 24 1980

RECEIVED

If well telescopes please sketch and show depths.

GROUND LEVEL

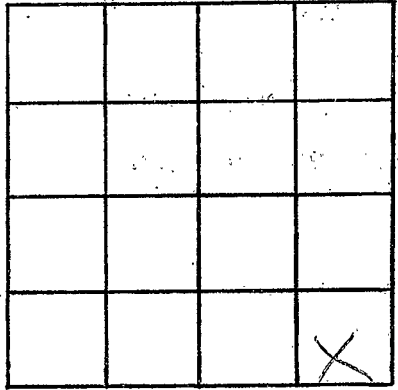

SECTION _____

Please indicate well location X.

ADDITIONAL INFORMATION

If more than one screen, show locations of each on sketch.