

Simpson
G. 2006

MISSISSIPPI
BOARD OF WATER COMMISSIONERS
416 North State Street
Jackson, Mississippi 39201

WATER WELL DRILLERS LOG

Dec 11 1987 A-1 Drilling Ser, Inc. Simpson
date well completed firm name county well located

LANDOWNER: <u>M. Earl Jackson</u>	description of formations encountered	from	to
<u>Rt 2, Box 6.</u>	<u>Top soil.</u>	<u>0</u>	<u>3</u>
<u>Braxton, Mo.</u>	<u>Fan clay</u>	<u>3</u>	<u>9</u>
(mailing address)	<u>Sand, to Orange</u>	<u>9</u>	<u>14</u>
WELL LOCATION:	<u>Tough, light tan clay</u>	<u>14</u>	<u>22</u>
sec <u>21</u> T <u>1</u> N R <u>2</u> E	<u>Hard, light gray clay.</u>	<u>22</u>	<u>50</u>
<u>± 5</u> miles <u>NE</u> of <u>Georgetown</u>	<u>Rock</u>	<u>50</u>	<u>50 1/2</u>
(distance) (direction) (nearest town)	<u>clay, hard, gray</u>	<u>50 1/2</u>	<u>98</u>
WELL PURPOSE: <u>Home</u>	<u>Sand</u>	<u>91</u>	<u>92</u>
(home) Irrigation, municipal, industrial	<u>Clay, gray, tough, up to 10"</u>	<u>92</u>	<u>108</u>
WELL COMPLETION DATA:	<u>Sand</u>	<u>108</u>	<u>108 1/2</u>
(1) diameter (inches) <u>2</u>	<u>Clay, gray, tough.</u>	<u>108 1/2</u>	<u>198</u>
(2) total depth (feet) <u>368</u>	<u>Sandy clay</u>	<u>108</u>	<u>204</u>
(3) static water level (feet) <u>56.5</u> below top of ground.	<u>Clay, gray, tough.</u>	<u>204</u>	<u>243</u>
(4) casing <u>Galv. Lt.</u> <u>357'</u>	<u>black streak</u>	<u>243</u>	<u>243 1/2</u>
(material) (depth)	<u>soft clay</u>	<u>243 1/2</u>	<u>282</u>
(size) if telescope see back.	<u>Sand, hard otk's clay</u>	<u>282</u>	<u>286</u>
(5) screen <u>10'</u> <u>357'</u>	<u>Sandy clay</u>	<u>286</u>	<u>289</u>
(length) (depth to top)	<u>Clay, gray</u>	<u>289</u>	<u>305</u>
<u>2"</u> <u>Stainless steel</u>	<u>Sand, gravel, fine</u>	<u>305</u>	<u>314</u>
(size) (material)	<u>Sand and clay (fine)</u>	<u>314</u>	<u>345</u>
(6) pump <u>1</u> <u>12</u>	<u>very fine sand, clay, black</u>	<u>345</u>	<u>354</u>
(HP) (yield gpm)	<u>sand, fine to well,</u>	<u>354</u>	<u>370</u>
<u>230V 1 φ</u>	<u>some coarse</u>		
(type power)			
(7) electric log <u>no</u>			
(yes or no)			
(organization running log)			
(8) how well bottom plugged <u>BWW</u>			


RECEIVED
DEC 17 1987

DRILLERS' REMARKS:

Department of Natural Resources
Bureau of Land & Water Resources

If well telescopes please sketch and show depths.

GROUND LEVEL

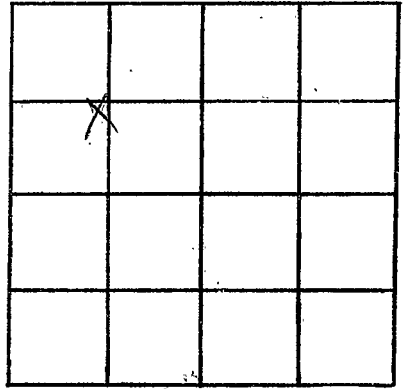

SECTION _____

Please indicate well location X.

ADDITIONAL INFORMATION

If more than one screen,
show locations of each on sketch.