

MISSISSIPPI DEPARTMENT OF ENVIRONMENTAL QUALITY

Office of Land and Water Resources

P. O. Box 10631  
Jackson, MS 39289-0631  
WATER WELL DRILLERS LOG

COUNTY WELL LOCATED <i>SIMPSON</i>	
WELL NUMBER <i>G-2009</i>	CODED
DATE WELL COMPLETED <i>5-31-02</i>	

PERMIT NUMBER
NAME OF DRILLING FIRM <i>WELLS SERVICE</i>

NAME & MAILING ADDRESS OF LANDOWNER <i>CHARLES BROWN</i>			
<i>H-34 SIMPSON HWY #69</i>			
<i>HARRISVILLE MS. 39082</i>			
Latitude:			
Longitude:			
WELL LOCATION.	SEC <i>26</i>	TOWNSHIP <i>N</i>	RANGE <i>2</i>
DISTANCE <i>6</i> Miles			
DIRECTION <i>WEST</i> of			
NEAREST TOWN <i>PINCH</i>			
OTHER LANDMARK			
WELL PURPOSE: Home, Irrigation, Municipal, Industrial, Fish Pond, etc. <i>HOME</i>			

PUMP DATA		
PUMP TYPE (Circle One): <input checked="" type="checkbox"/> Submersible, <input type="checkbox"/> Turbine, <input type="checkbox"/> Jet, <input type="checkbox"/> Flowing Well, Other (Describe)		
POWER TYPE (Circle One): <input checked="" type="checkbox"/> Electric, <input type="checkbox"/> Tractor, <input type="checkbox"/> Diesel, <input type="checkbox"/> Gasoline, <input type="checkbox"/> Butane, Other (Describe) <i>H/P</i> <i>12</i>		
DESCRIPTION OF FORMATIONS ENCOUNTERED	FROM	TO
<i>Red CLAY</i>	<i>0</i>	<i>40</i>
<i>CLAY</i>	<i>40</i>	<i>160</i>
<i>SAND &amp; CLAY</i>	<i>160</i>	<i>150</i>
<i>SOFT SAND</i>	<i>150</i>	<i>285</i>
<b>RECEIVED</b>		
<i>JUN 21 2002</i>		
<b>BY: OLWR</b>		
Top of Lap Pipe or Reduction in Casing		
FEET	IF TELESCOPED OR MORE THAN ONE SCREEN: USE BACK PAGE	

WELL DATA		
Well Depth <i>280</i>	Casing Diameter (In.) <i>4"</i>	Casing Length (Ft.) <i>270</i>
Type of Casing <i>PVC</i>	Hole Depth <i>285</i>	Depth to Static Water Level <i>95'</i>
TYPE OF COMPLETION: (Circle One or More): <input checked="" type="checkbox"/> Gravel Packed, <input type="checkbox"/> Underreamed, <input type="checkbox"/> Telescoped, <input checked="" type="checkbox"/> Natural Development, <input type="checkbox"/> Open Hole, <input type="checkbox"/> Other (Describe)		
WELL GROUTED TO A DEPTH OF <i>12</i> FEET		
Type Grout (circle one): Cement, Bentonite, or Mix		

SCREEN DATA		
Diameter - Inches <i>4"</i>	Length - Feet <i>10'</i>	Slot Size - Inches <i>008</i>
Screen Type <i>PVC</i>	Depth to Bottom - Feet <i>280</i>	


I certify that the well was drilled, constructed and completed in accordance with all applicable Requirements of the Mississippi Department of Environmental Quality and/or the Mississippi Department of Health regulations and state laws.

*Johnny R. Papp*  
Signature of Licensed Driller and License No.

*6-14-02*  
Date

If well telescopes please sketch and show depths.

GROUND LEVEL

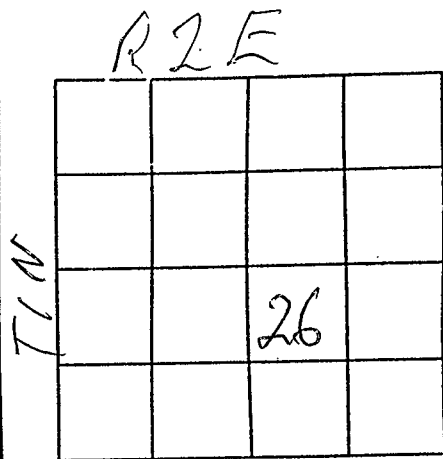

SECTION 26

Please indicate well location X.

Pump Capacity (GPM)	No. of Stages	Setting Depth	
20	14	180	FT.
PUMP TEST			
Well yielded <u>22</u> GPM with			
a drawdown of <u>40'</u> ft.			
after <u>24</u> hours of pumping			

LOG DATA

TYPE OF LOG RUN (Circle One):      No Log Run.  
 Electric, Gamma Ray, Density, Sonic, Neutron.  
 Other (Describe) \_\_\_\_\_

Name of Organization Running Log \_\_\_\_\_

GEOLOGIC DATA (Office Use Only)

Surface Elev.	Geologic Unit	Unit Thickness	Depth to Top
Subs. SWL	Date	Analysis	Aquifer Test

Driller's Remarks

GO WEST ON 28 PAST  
NINOLA TO 469 NORTH  
GO 3 MILES HOUSE  
ON RIGHT BIG  
BRICK HOUSE

If more than one screen, show location of each on sketch.