

E-log # 105

MISSISSIPPI
BOARD OF WATER COMMISSIONERS
416 North State Street
Jackson, Mississippi 39201

CODED

Simpson
H4
4-8-70

WATER WELL DRILLERS LOG

4/8 1970 St. R Simpson
date well completed firm name county well located

LANDOWNER: Burney Barber
Rt 1

Pinola, Miss.
(mailing address)

WELL LOCATION:
sec. 30 T. 1 N. 2 R. 3 E.
S. W. W. of Pinola
(distance) miles (direction) (nearest town)

WELL PURPOSE: Home
(home, irrigation, municipal, industrial)

WELL COMPLETION DATA:

- (1) diameter (inches) 2"
- (2) total depth (feet) 236
- (3) static water level (feet) 8.5 below top of ground.
- (4) casing Galv. 126
(material) (depth)
2" if telescope see back.
(size)
- (5) screen 10 426
(length) (depth to top)
2" S/S
(size) (material)
- (6) pump 1 720
(HP) (yield gpm)
1/2
(type power)
- (7) electric log M.A.S.
(yes or no)
M.A.S.
(organization running log)
- (8) how well bottom plugged None

description of formations encountered	from	to
Clay	0	10
Hard Sand	10	25
Fine Sand	25	49
Coarse Clay	49	52
Sand	52	57
Clay	57	95
Fine Sand	95	102
Clay	102	127
Blue Shale	127	152
Blue Clay	152	182
Sand + Clay	182	192
Shale Pipe	192	206
Fine Sand	206	222
Hard Clay	222	248
Hard Sand	248	252
Rock	252	278
Blue Shale	278	292
Rock	292	322
Fine Sand	322	352
Blue Shale	352	372
Fine Sand	372	408
Shale + Sand	408	420
Fine Sand	420	423
Fine Sand	423	435
CW B Sand	435	445
Fine Sand + Shale	445	508


MAY 4 1970

DRILLERS REMARKS:

MISS. Bd. OF
WATER

If well telescopes please sketch and show depths.

GROUND LEVEL

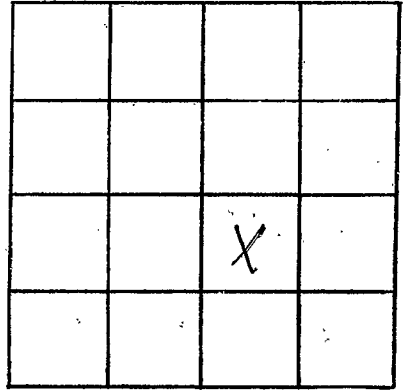

SECTION 30

Please indicate well location X.

ADDITIONAL INFORMATION

If more than one screen,
show locations of each on sketch.