

SIMPSON  
H5  
4-30-70

MISSISSIPPI  
BOARD OF WATER COMMISSIONERS  
416 North State Street  
Jackson, Mississippi 39201

WATER WELL DRILLERS LOG

**CODED**

4/30/70 date well completed      STR firm name      Simpson county well located

LANDOWNER New Zion Church

description of formations encountered	from	to
Red Clay	0	9
Sand	9	13
Whiting Clay	13	14
Sand	14	20
Clay Slip	20	21
Sand	21	28
Blue Shale Hard	28	314
Rock	314	316
Sandy Shale	316	356
Hard Blue Clay	356	384
Sand	384	409
Shale Clay	409	410
Sand & Shale	410	420

Pineola, Miss (mailing address)

WELL LOCATION:  
sec 9B T-1 (N) R-3 (E)  
2 miles West of Pineola  
(distance) (direction) (nearest town)

WELL PURPOSE: Home  
(home, irrigation, municipal, industrial)

- WELL COMPLETION DATA:
- (1) diameter (inches) 4"
  - (2) total depth (feet) 409
  - (3) static water level (feet) 21 below above top of ground.
  - (4) casing 399 (material) (depth)
  - 4x2 (size) if telescope see back.
  - (5) screen 1.0 (length) 399 (depth to top)
  - 2" (size) S/S (material)
  - (6) pump 1/2 (HP) 30 (yield gpm)
  - Sub (type power)
  - (7) electric log Yes (yes or no)
  - MAS (organization running log)
  - (8) how well bottom plugged None


**CODED**

JUL 7 1970

DRILLERS REMARKS:

MISS. BD. OF  
WATER COMM.

If well telescopes please sketch and show depths.

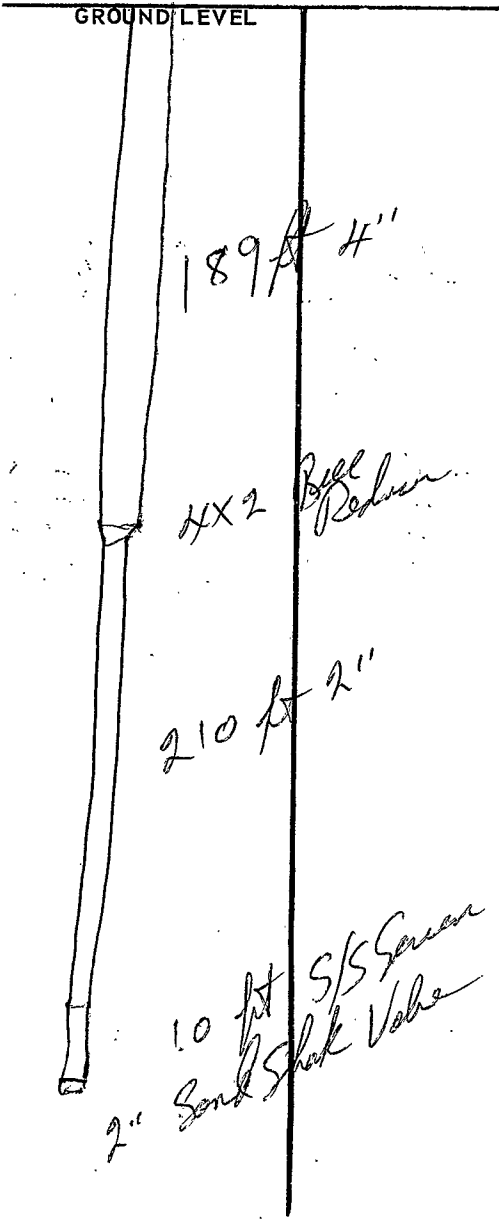

X			

SECTION 28

Please indicate well location X.

ADDITIONAL INFORMATION

If more than one screen,  
show locations of each on sketch.