

**SIMPSON**  
**H 7**  
**1-15-71**

MISSISSIPPI  
 BOARD OF WATER COMMISSIONERS  
 416 North State Street  
 Jackson, Mississippi 39201

**CODED**

**WATER WELL DRILLERS LOG**

Jan 15 1971 R. E. Thompson Simpson  
 date well completed firm name county/well located

**LANDOWNER:**  
J. Marshall Brown  
Mendenhall Grains  
 (mailing address)

description of formations encountered	from	to
<u>Top Soil</u>	<u>0</u>	<u>5</u>
<u>Heavy clay</u>	<u>5</u>	<u>30</u>
<u>Blue clay</u>	<u>30</u>	<u>240</u>
<u>Sand</u>	<u>240</u>	<u>263</u>

**WELL LOCATION:**  
 sec. 12 T 1 N R 3 E  
3 miles S/W of P. Loo  
 (distance) (direction) (nearest town)

**WELL PURPOSE:** home  
 (home, irrigation, municipal, industrial)

- WELL COMPLETION DATA:**
- (1) diameter (inches) 2"
  - (2) total depth (feet) 263'
  - (3) static water level (feet) 38 below above top of ground.
  - (4) casing Plastic 180'  
 (material) (depth)  
2" if telescope see back.  
 (size)
  - (5) screen Open  
 (length) (depth to top)  
 (size) (material)
  - (6) pump 1 8  
 (HP) (yield gpm)  
Just  
 (type power)
  - (7) electric log no  
 (yes or no)
  - (organization running log)
  - (8) how well bottom plugged Open

**CODED**


FEB 8 1971

MISS. Bd. of  
 WATER COMMISSIONERS

**DRILLERS REMARKS:**

If well telescopes please sketch and show depths.

GROUND LEVEL:

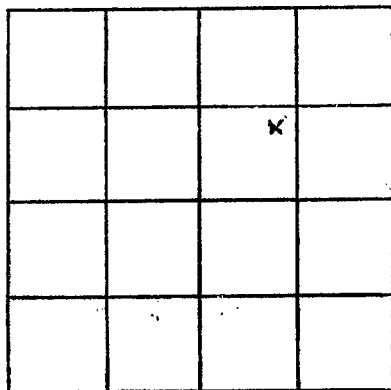

SECTION 12

Please indicate well location X.

ADDITIONAL INFORMATION

If more than one screen,  
show locations of each on sketch.