

SIMPSON  
H10  
Fl. # 166

MISSISSIPPI  
BOARD OF WATER COMMISSIONERS  
416 North State Street  
Jackson, Mississippi 39201

*Caded*

WATER WELL DRILLERS LOG


8/7/72 19 *H. E. Thompson* *Simpson*  
date well completed firm name county well located

LANDOWNER:	description of formations encountered	from	to
<i>Kelly, Barry</i>			
(mailing address)	<i>gravel</i>	15	38'
WELL LOCATION:	<i>Blue clay</i>	38	230
sec. <u>31</u> T <u>1</u> N R <u>3</u> E S W	<i>sand</i>	230	240
<u>4</u> miles <u>NW</u> of <u>Pinola</u> (distance) (direction) (nearest town)	<i>Blue clay</i>	240	250
WELL PURPOSE: (home, irrigation, municipal, industrial)	<i>sand</i>	250	427
WELL COMPLETION DATA:			
(1) diameter (inches) <u>2"</u>			
(2) total depth (feet) <u>427'</u>			
(3) static water level (feet) <u>1'</u> <del>above</del> above top of ground.			
(4) casing <u>Plastic H10'</u> (material) (depth)			
<u>2"</u> (size) if telescope see back.			
(5) screen <u>15'</u> <u>H10'</u> (length) (depth to top)			
<u>.008</u> <u>Plastic</u> (size) (material)			
(6) pump <u>1/2</u> <u>6</u> (HP) (yield gpm)			
<u>gas</u> (type power)			
(7) electric log <u>yes</u> (yes or no)			
<u>M. S. S.</u> (organization running log)			
(8) how well bottom plugged <u>Gravel</u>			
DRILLERS REMARKS:			

AUG 30 1972

If well telescopes please sketch and show depths.

GROUND LEVEL

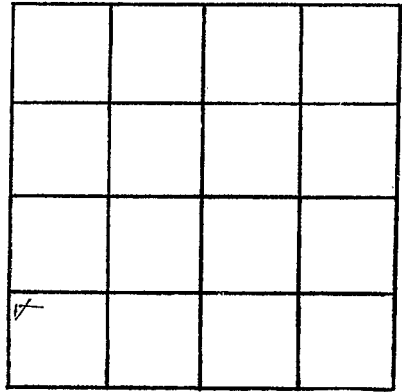

SECTION 31

Please indicate well location X.

ADDITIONAL INFORMATION

If more than one screen, show locations of each on sketch.