

MISSISSIPPI DEPARTMENT OF NATURAL RESOURCES

Bureau of Land and Water Resources

Southport Mall

P.O. Box 10631

Jackson, Mississippi 39209

WATER WELL DRILLERS LOG

SIMPSON
H12
7/79
E log # 234

date well completed 7-19-79 firm name Jack D. Quinn county well located Simpson

LANDOWNER:	description of formations encountered	from	to
(mailing address)			
<u>John Mae Intosh</u>	<u>strata gravel</u>	<u>0</u>	<u>60</u>
	<u>CLAY</u>	<u>60</u>	<u>360</u>
	<u>SHAL</u>	<u>360</u>	<u>380</u>
WELL LOCATION:			
sec <u>33</u> T <u>1</u> N R <u>3</u> E			
(distance) miles (direction) of (nearest town)			
WELL PURPOSE:			
(home, irrigation, municipal, industrial) <u>home</u>			
WELL COMPLETION DATA:			
(1) diameter (inches) <u>2"</u>			
(2) total depth (feet) <u>360</u>			
(3) static water level (feet) <u>2</u> below top of ground.			
(4) casing <u>POC</u> <u>360</u> (material) (depth)			
<u>2</u> (size) if telescope see back.			
(5) screen <u>20</u> <u>360</u> (length) (depth to top)			
<u>2</u> (size) <u>POC</u> (material)			
(6) pump <u>1</u> <u>10</u> (HP) (yield gpm)			
(type power)			
(7) electric log <u>yes</u> (yes or no)			
<u>MGS</u> (organization running log)			
(8) how well bottom plugged			

DEPT. OF NATURAL RESOURCES  
BUREAU OF LAND & WATER RESOURCES


DEC - 9 1980

RECEIVED

DRILLERS REMARKS:

If well telescopes please sketch and show depths.

GROUND LEVEL

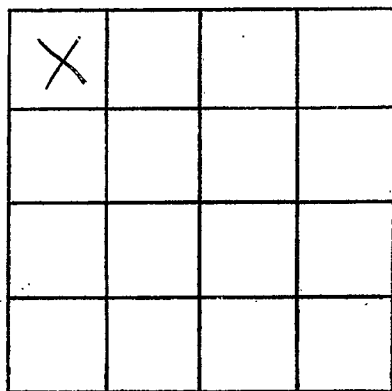

SECTION 33

Please indicate well location X.

ADDITIONAL INFORMATION

If more than one screen,  
show locations of each on sketch.