

SIMPSON
 H13
 8-4-81
 Log # 267
 0-4


MISSISSIPPI
 BOARD OF WATER COMMISSIONERS
 416 North State Street
 Jackson, Mississippi 39201

COMED
 4

WATER WELL DRILLERS LOG


1981 date well completed *0-4* firm name *St. Gunn well ser. Simpson* county well located *Simpson*

LANDOWNER:	description of formations encountered	from	to
<i>Stony River Camp</i> (mailing address)	<i>Sand & gravel</i> <i>CLAY</i>	<i>0</i> <i>40</i>	<i>40</i> <i>100</i>
WELL LOCATION: sec. <i>33</i> T <i>1</i> N R <i>3</i> E S W (distance) _____ miles _____ of _____ (direction) _____ (nearest town)	<i>Sand</i> <i>CLAY</i> <i>Sand</i> <i>CLAY</i> <i>Sand</i>	<i>60</i> <i>70</i> <i>140</i> <i>160</i> <i>340</i>	<i>70</i> <i>100</i> <i>160</i> <i>300</i> <i>385</i>
WELL PURPOSE: (home, irrigation, municipal, industrial)			
WELL COMPLETION DATA:			
(1) diameter (inches) <i>2"</i>			
(2) total depth (feet) <i>385</i>			
(3) static water level (feet) <i>20'</i> ^{below} above top of ground.			
(4) casing <i>PVC</i> <i>385</i> (material) (depth) <i>2"</i> (size) If telescope see back.			
(5) screen <i>20'</i> <i>265</i> (length) (depth to top) <i>2"</i> <i>PVC</i> (size) (material)			
(6) pump _____ (HP) _____ (yield gpm) (type power) _____			
(7) electric log _____ (yes or no) (organization running log) _____			
(8) how well bottom plugged <i>BWV</i>			
DRILLERS REMARKS:			

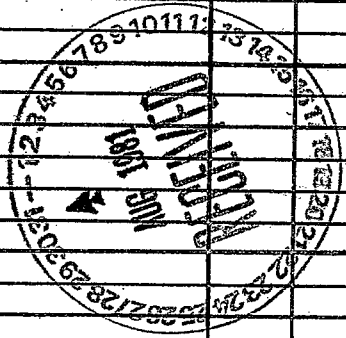

If well telescopes please sketch and show depths.

GROUND LEVEL

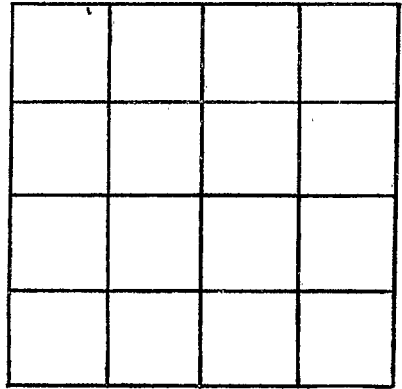

SECTION _____

Please indicate well location X.

ADDITIONAL INFORMATION

If more than one screen, show locations of each on sketch.