

SIMPSON
H15
3-10-83
296

MISSISSIPPI
 BOARD OF WATER COMMISSIONERS CODED
 416 North State Street
 Jackson, Mississippi 39201
 WATER WELL DRILLERS LOG

3-10 19**83** **Guinn well Simpson**
 date well completed firm name county well located

LANDOWNER:
Steve Banks
 (mailing address)

description of formations encountered	from	to
CLAY	0	40
Sand & GRAVEL	40	50
CLAY	50	446
Sand	446	456

WELL LOCATION:
 sec **3** T **1** N **5** R **3** E **W**
 (distance) miles (direction) of (nearest town)

WELL PURPOSE:
 (home, irrigation, municipal, industrial)

- WELL COMPLETION DATA:
- (1) diameter (inches) **2"**
 - (2) total depth (feet) **456**
 - (3) static water level (feet) **30** below top of ground.
 - (4) casing **PVC** **446**
 (material) (depth)
2"
 (size) If telescope see back.
 - (5) screen **10** **446**
 (length) (depth to top)
2" **PVC**
 (size) (material)
 - (6) pump **1** **10**
 (HP) (yield gpm)
 (type power)
 - (7) electric log _____
 (yes or no)
MOS
 (organization running log)
 - (8) how well bottom plugged **Back**

DRILLERS REMARKS:


DEPT. OF NATURAL RESOURCES
 BUREAU OF LAND & WATER RESOURCES

NOV - 7 1983

RECEIVED

If well telescopes please sketch and show depths.

GROUND LEVEL

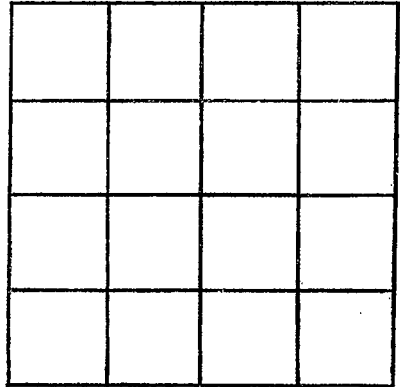

SECTION _____

Please indicate well location X.

ADDITIONAL INFORMATION

If more than one screen,
show locations of each on sketch.