

SIMPSON  
 H19  
 10-7-77  
 Log # 194

MISSISSIPPI  
 BOARD OF WATER COMMISSIONERS  
 416 North State Street  
 Jackson, Mississippi 39201

CODED

WATER WELL DRILLERS LOG

10-7-77 date well completed 19 Guinn Waterwellers firm name Simpson county well located

LANDOWNER:  
 WALTERS, R  
 (mailing address)

description of formations encountered	from	to
SAND	0	30
CLAY	30	140
SAND	140	155
CLAY	155	180
SAND	180	193

WELL LOCATION:  
 sec. 33 T-1 N R-3 E  
 (distance) miles (direction) of (nearest town)

WELL PURPOSE:  
 (home, irrigation, municipal, industrial)

- WELL COMPLETION DATA:
- (1) diameter (inches) 2"
  - (2) total depth (feet) 193
  - (3) static water level (feet) 12 -below-  
above top of ground.
  - (4) casing PVC (material), 173 (depth)  
 2 (size) if telescope see back.
  - (5) screen 20 (length), 173 (depth to top)  
 2 (size), PVC (material)
  - (6) pump Did NOT (HP) (yield gpm)  
 Set PUMP (type power)
  - (7) electric log (yes or no)  
 MRS (organization running log)
  - (8) how well bottom plugged 13 cu

CODED


DRILLERS REMARKS:

RECEIVED  
 NOV 16 1977

MISS. RD. OF WATER

If well telescopes please sketch and show depths.

GROUND LEVEL

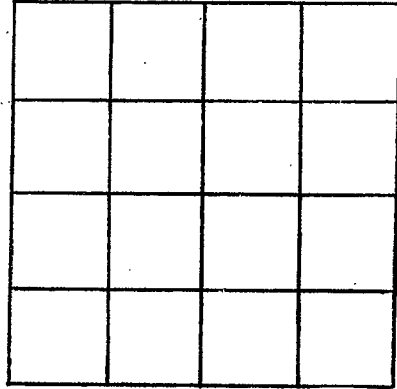

SECTION \_\_\_\_\_

Please indicate well location X.

ADDITIONAL INFORMATION

If more than one screen, show locations of each on sketch.