

Simpson
H 20

MISSISSIPPI
BOARD OF WATER COMMISSIONERS
416 North State Street
Jackson, Mississippi 39201

CODED.

WATER WELL DRILLERS LOG

H-4-85 19
date well completed

Gunn well see Simpson
firm name county well located

LANDOWNER:

Jim Berry

(mailing address)

WELL LOCATION:

sec. 3 T 1 N R 3 E
S W

(distance) miles (direction) of (nearest town)

WELL PURPOSE:

(home, irrigation, municipal, industrial)

WELL COMPLETION DATA:

- (1) diameter (inches) 9"
- (2) total depth (feet) 210'
- (3) static water level (feet) 8' below top of ground.
- (4) casing PVC 190'
(material) (depth)
2" (size) If telescope see back.
- (5) screen 20' 190'
(length) (depth to top)
9" (size) PVC (material)
- (6) pump 1 4
(HP) (yield gpm)

(type power)

- (7) electric log (yes or no)
MGS
(organization running log)


- (8) how well bottom plugged BCW

description of formations encountered

from to

Sand & gravel	0	80
CLAY	80	190
SAND	190	210

CODED.

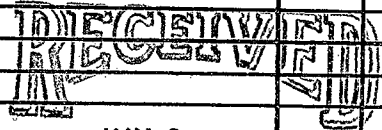


JUN 25 1980

DRILLERS REMARKS:

Department of Natural Resources
Bureau of Land & Water Resources

If well telescopes please sketch and show depths.

GROUND LEVEL

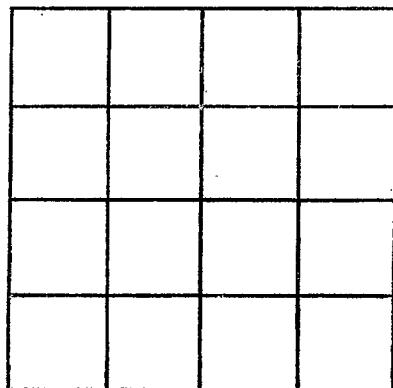

SECTION _____

Please indicate well location X.

ADDITIONAL INFORMATION

If more than one screen,
show locations of each on sketch.