

Jimpson
#21

MISSISSIPPI
 BOARD OF WATER COMMISSIONERS
 416 North State Street
 Jackson, Mississippi 39201

CODED

WATER WELL DRILLERS LOG

1-22 1986 Bob W. Wells Simpson
 date well completed firm name county well located

LANDOWNER:
Southern Bank
 (mailing address)


description of formations encountered	from	to
<u>Sand & gravel</u>	<u>0</u>	<u>130</u>
<u>CLAY</u>	<u>130</u>	<u>410</u>
<u>Sand</u>	<u>410</u>	<u>420</u>

WELL LOCATION:
 sec 30 T 1 N R 3 E
 (distance) miles _____ of _____ (direction) (nearest town)

WELL PURPOSE:
 (home, irrigation, municipal, industrial)

- WELL COMPLETION DATA:
- (1) diameter (inches) 2"
 - (2) total depth (feet) 420
 - (3) static water level (feet) 60 below top of ground.
 - (4) casing PVC 410
 (material) (depth)
2" if telescope see back.
 (size)
 - (5) screen 10' 410
 (length) (depth to top)
2" PVC
 (size) (material)
 - (6) pump 1 4
 (HP) (yield gpm)
 (type power)
 - (7) electric log yes
 (yes or no)
MCS
 (organization running log)
 - (8) how well bottom plugged BWV

CODED

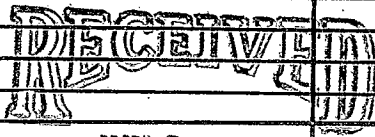


JUN 9 5 1986

DRILLERS REMARKS:

If well telescopes please sketch and show depths.

GROUND LEVEL

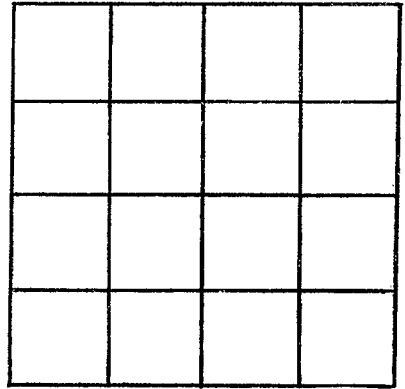

SECTION _____

Please indicate well location X.

ADDITIONAL INFORMATION

If more than one screen,
show locations of each on sketch.