

MISSISSIPPI DEPARTMENT OF NATURAL RESOURCES

Bureau of Land and Water Resources

| | |
|---------------------|-------|
| COUNTY WELL LOCATED | |
| Simpson | |
| WELL NUMBER | CODED |
| H 23 | V |
| DATE WELL COMPLETED | |
| 7-12-90 | |

PERMIT NUMBER

NAME OF DRILLING FIRM

Roy D. West

P.O. Box 10631

Jackson, Mississippi 39209

WATER WELL DRILLERS LOG

NAME & MAILING ADDRESS OF LANDOWNER

Dale Gordon

P.O. Box 3

Braxton MS 39044

WELL LOCATION: SEC TOWNSHIP RANGE

27 1 N 3 E

DISTANCE DIRECTION NEAREST TOWN

2 Miles N of Pinola

OTHER LANDMARK

WELL PURPOSE ☒ Home Irrigation, Municipal, Industrial, Fish Pond, etc.

PUMP DATA

PUMP TYPE (Circle One):

☒ Submersible, ☐ Turbine, ☐ Jet, ☐ Flowing Well,
Other (Describe)

POWER TYPE (Circle One):

☒ Electric, ☐ Tractor, ☐ Diesel, ☐ Gasoline, ☐ Butane,
Other (Describe) H/P 2

Pump Capacity (GPM)

12

No. of Stages

Setting Depth

40' FT.

PUMP TEST

Well yielded _____ GPM with

a drawdown of _____ ft.

after _____ hours of pumping

WELL DATA

| | | |
|--|-----------------------|--|
| Well Depth | Casing Diameter (In.) | Casing Length (Ft.) |
| 355' | 4" | 345' |
| Type of Casing | Hole Depth | Depth to Static Water Level |
| PVC | 355 | +2 ABOVE |
| TYPE OF COMPLETION: (Circle One or More): | | |
| <input checked="" type="radio"/> Gravel Packed, <input type="radio"/> Underreamed, <input type="radio"/> Telescoped, <input checked="" type="radio"/> Natural Development, <input type="radio"/> Open Hole, <input type="radio"/> Other | | |
| Top of Lap Pipe or Reduction in Casing | | |
| FEET | | IF TELESCOPED OR MORE THAN ONE SCREEN: USE BACK PAGE |

LOG DATA

TYPE OF LOG RUN (Circle One):

☒ No Log Run, ☐ Electric, ☐ Gamma Ray, ☐ Density, ☐ Sonic, ☐ Neutron,
Other (Describe)

Name of Organization Running Log

GEOLOGIC DATA (Office Use Only)

| | | | |
|---------------|---------------|----------------|--------------|
| Surface Elev. | Geologic Unit | Unit Thickness | Depth to Top |
| Subs. SWL | Date | Analysis | Aquifer Test |

Driller's Remarks

SCREEN DATA

| | | |
|-------------------|------------------------|--------------------|
| Diameter - Inches | Length - Feet | Slot Size - Inches |
| 4" | 10' | .010 |
| Screen Type | Depth to Bottom - Feet | |
| PVC | 355' | |

| DESCRIPTION OF FORMATIONS ENCOUNTERED | FROM | TO |
|---------------------------------------|------|-----|
| SAND | 0 | 23 |
| CLAY w/ rocks str | 23 | 148 |
| silty sand | 148 | 162 |
| CLAY | 162 | 332 |
| SAND | 332 | 355 |

FORMATIONS (Continued)

FROM

TO

RECEIVED


JUL 30 1990

Department of Natural Resources
Bureau of Land & Water Resources

IF MORE SPACE IS NEEDED, USE BACK

If well telescopes please
sketch and show depths.

GROUND LEVEL

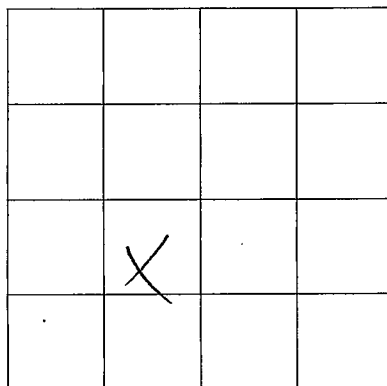

SECTION 27

Please indicate well location X.

ADDITIONAL INFORMATION

If more than one screen,
show location of each on sketch.