

SIMPSON
H 2000
11-1-75

MISSISSIPPI
BOARD OF WATER COMMISSIONERS
416 North State Street
Jackson, Mississippi 39201

WATER WELL DRILLERS LOG

11-1 date well completed 1975 W. K. Barnes & Co. firm name Simpson county well located

LANDOWNER: George Lacy
Brantley Miss
pt. 1
(mailing address)

WELL LOCATION:
sec. 7 T. 10 N. R. 3 E.
3 (?) miles S-E of Brantley
(distance) (direction) (nearest town)

WELL PURPOSE: Home use
(home, irrigation, municipal, industrial)

WELL COMPLETION DATA:
(1) diameter (inches) 2
(2) total depth (feet) 396
(3) static water level (feet) 15 below top of ground.
(4) casing Galv. (material) (depth)
2" (size) if telescope see back.
(5) screen 8 ft. (length) (depth to top)
06 (size) Si S. (material)
(6) pump 1 1/2 (HP) 15 (yield gpm)
Elec. (type power)
(7) electric log no (yes or no)
(organization running log)
(8) how well bottom plugged Wash with


description of formations encountered	from	to
Red Clay	0	8
yellow clay	8	30
Blue Clay	30	46
Fine Sand	46	52
Blue Clay	52	89
Rock	89	91
Blue Clay	91	106
Fine Sand	106	108
Blue Clay	108	240
Fine Sand	240	260
Blue Clay	260	348
Fine Sand	348	365
Coarse Sand	365	396

DRILLERS REMARKS:

NOV 1 1975

If well telescopes please sketch and show depths.

GROUND LEVEL

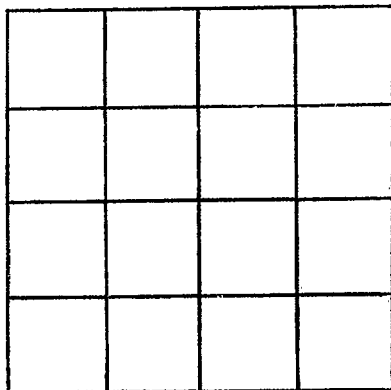

SECTION 7

Please indicate well location X.

ADDITIONAL INFORMATION

If more than one screen,
show locations of each on sketch.