

SIMPSON  
H 2002  
1/18/78

MISSISSIPPI  
BOARD OF WATER COMMISSIONERS  
416 North State Street  
Jackson, Mississippi 39201

WATER WELL DRILLERS LOG

Jan. 18 1978 date well completed  
Tom Griffith Plumbing + S. Simpson firm name  
Well county well located

LANDOWNER:  
Larry Broadhead  
(mailing address)

description of formations encountered	from	to
Top Soil	0	2
Clay	2	40
Clay	40	81
Sand	81	100

WELL LOCATION:  
sec. 28 T 1 N R 3 E  
S W  
2 miles NW of Pinebluff  
(distance) (direction) (nearest town)

WELL PURPOSE: Home  
(home, irrigation, municipal, industrial)

- WELL COMPLETION DATA:
- (1) diameter (inches) 2"
  - (2) total depth (feet) 100 ft.
  - (3) static water level (feet) 60 ft. below top of ground.
  - (4) casing Plastic, 80 ft.  
(material) (depth)  
2" If telescope see back.  
(size)
  - (5) screen 20 ft. 80 ft.  
(length) (depth to top)  
2" Plastic  
(size) (material)
  - (6) pump 1/2 5  
(HP) (yield gpm)  
Elec.  
(type power)
  - (7) electric log No  
(yes or no)
  - (8) how well bottom plugged  
B.W. Valve


DRILLERS REMARKS:

RECEIVED  
MAR 31 1978

MISS. BD. OF WATER COMMISSIONERS

If well telescopes please sketch and show depths.

GROUND LEVEL

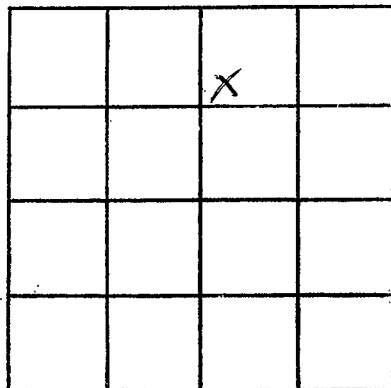

SECTION \_\_\_\_\_

Please indicate well location X.

ADDITIONAL INFORMATION

If more than one screen,  
show locations of each on sketch.