

SIMPSON
 # 2003
 5/13/80

MISSISSIPPI
 BOARD OF WATER COMMISSIONERS
 416 North State Street
 Jackson, Mississippi 39201

WATER WELL DRILLERS LOG

MAY 13 1980 Roy WEST ORLG Simpson
 date well completed firm name county well located

LANDOWNER:
 Kelly Berry
 Pindola
 (mailing address)

description of formations encountered	from	to
CLAY	0	10
SAND	10	40
GRAY CLAY	40	150
BLUE CLAY	150	370
SAND	370	398

WELL LOCATION:
 sec. 33 T 1 N R 3 E
 S W
 10 miles E of Pindola
 (distance) (direction) (nearest town)

WELL PURPOSE: HOME
 (home, irrigation, municipal, industrial)

- WELL COMPLETION DATA:
- (1) diameter (inches) 2"
 - (2) total depth (feet) 398'
 - (3) static water level (feet) 23' below above top of ground.
 - (4) casing PVC, 388'
 (material) (depth)
 (size) If telescope see back.
 - (5) screen 10', 385'
 (length) (depth to top)
2", PVC
 (size) (material)
 - (6) pump 1, 12
 (HP) (yield gpm)
REA
 (type power)
 - (7) electric log NO
 (yes or no)
 (organization running log)
 - (8) how well bottom plugged WASH VALVE

DRILLERS REMARKS:


DEPT. OF NATURAL RESOURCES
 BUREAU OF LAND & WATER RESOURCES

JUN 18 1980

RECEIVED

If well telescopes please sketch and show depths.

GROUND LEVEL

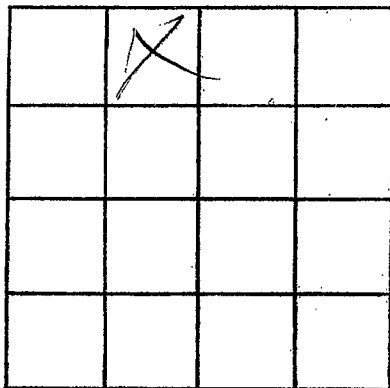

SECTION 23

Please indicate well location X.

ADDITIONAL INFORMATION

If more than one screen, show locations of each on sketch.