

SIMPSON
H 2004
8-12-80

MISSISSIPPI
BOARD OF WATER COMMISSIONERS
416 North State Street
Jackson, Mississippi 39201

WATER WELL DRILLERS LOG

Aug 12 1980 C.P. Clark Water Wells Simpson
date well completed firm name county well located


LANDOWNER: Jerome Berry	description of formations encountered	from	to
Pinola, Miss.	Hard sandy clay	0	4
(mailing address)	Clay	4	15
WELL LOCATION:	Sand and gravel	15	39
sec 31 T 1 N R 3 E	Hard clay	39	50
4 miles W of Pinola			
(distance) (direction) (nearest town)			
WELL PURPOSE: (home, irrigation, municipal, industrial)			
WELL COMPLETION DATA:			
(1) diameter (inches) 2			
(2) total depth (feet) 44			
(3) static water level (feet) 15 below top of ground.			
(4) casing Galv 34' (material) (depth)			
2" (size) if telescope see back.			
(5) screen 5' 34' (length) (depth to top)			
1/4" (size) stainless steel (material)			
(6) pump 1 8 (HP) (yield gpm)			
2300 1φ (type power)			
(7) electric log no (yes or no)			
(organization running log)			
(8) how well bottom plugged BWV			
DRILLERS REMARKS:			

DEPT. OF NATURAL RESOURCES
BUREAU OF LAND & WATER RESOURCES

SEP 8 - 1980
RECEIVED

If well telescopes please sketch and show depths.

GROUND LEVEL

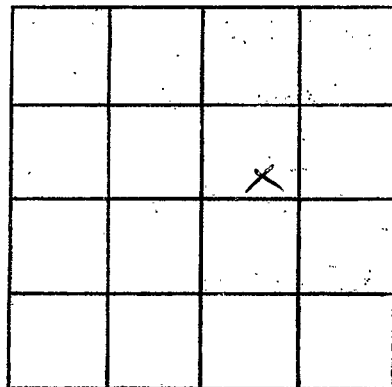

SECTION 13

Please indicate well location X.

ADDITIONAL INFORMATION

If more than one screen, show locations of each on sketch.