

SIMPSON
 J
 9-21-77
 Log # 192
 9-21-77
 date well completed

MISSISSIPPI
 BOARD OF WATER COMMISSIONERS
 416 North State Street
 Jackson, Mississippi 39201

CODED

WATER WELL DRILLERS LOG

19 Summer water well SIMPSON
 firm name county well located

LANDOWNER:
MARY THOMPSON
 (mailing address)

description of formations encountered	from	to
SAND	0	90
CLAY	90	160
SAND	160	195

WELL LOCATION:
 sec. 35 T-1 N R-4 E
 S W
 (distance) miles (direction) of (nearest town)

WELL PURPOSE:
 (home, irrigation, municipal, industrial)

WELL COMPLETION DATA:

(1) diameter (inches) 2"

(2) total depth (feet) 195

(3) static water level (feet) 47 ^{below} ~~above~~ top of ground.

(4) casing PVC 195
 (material) (depth)
2" if telescope see back.
 (size)

(5) screen 20 195
 (length) (depth to top)
2 PVC
 (size) (material)

(6) pump 1 4
 (HP) (yield gpm)

(type power)

(7) electric log (yes or no)
no
 (organization running log)


(8) how well bottom plugged Bad

DRILLERS REMARKS:

RECEIVED
 NOV 16 1977

If well telescopes please sketch and show depths.

GROUND LEVEL

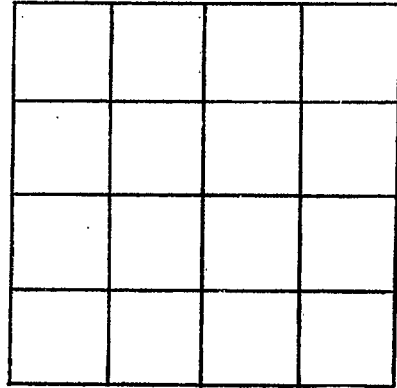

SECTION _____

Please indicate well location X.

ADDITIONAL INFORMATION

If more than one screen, show locations of each on sketch.