

Simpson  
J

MISSISSIPPI  
BOARD OF WATER COMMISSIONERS  
416 North State Street  
Jackson, Mississippi 39201

WATER WELL DRILLERS LOG

11-3 1983 date well completed  
13 Gunnwellsea SIMPSON firm name  
county well located

LANDOWNER:

BUCK MORRIS

(mailing address)

WELL LOCATION:

sec. 7 T 1 N R 4 E  
S W

(distance) miles (direction) of (nearest town)

WELL PURPOSE:

(home, irrigation, municipal, industrial)

WELL COMPLETION DATA:

- (1) diameter (inches) 4"
- (2) total depth (feet) 260
- (3) static water level (feet) 28 below top of ground.
- (4) casing POC 240 (material) (depth)
- 4 (size) if telescope see back.
- (5) screen 20 240 (length) (depth to top)
- 4 POC (size) (material)
- (6) pump 34 15 (HP) (yield gpm)

(type power)

(7) electric log (yes or no)

(organization running log)

(8) how well bottom plugged B.W.V.

DRILLERS REMARKS:

description of formations encountered

from to

CLAY	0	80
SAND	80	100
CLAY	100	120
SAND	120	130
CLAY	130	140
SAND	140	160
	160	260


DEPT. OF NATURAL RESOURCES  
BUREAU OF LAND & WATER RESOURCES

NOV - 9 1983

RECEIVED

If well telescopes please sketch and show depths.

GROUND LEVEL

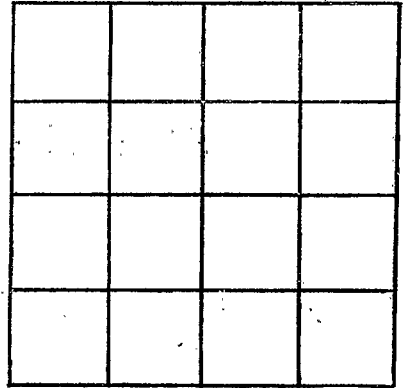

SECTION \_\_\_\_\_

Please indicate well location X.

ADDITIONAL INFORMATION

If more than one screen,  
show locations of each on sketch.