

EL. 66
485

MISSISSIPPI
BOARD OF WATER COMMISSIONERS

416 North State Street
Jackson, Mississippi 39201

WATER WELL DRILLERS LOG

CODED

Simpson
T1
1-67
E-109

1-24 1967 date well completed
Water Well Dr. Co. firm name
Simpson county well located

LANDOWNER: Fred Adams
AA Chicken Farm
Mendenhall, Miss.
(mailing address)

description of formations encountered	from	to
	<u>Clay + Sand</u>	<u>0</u>
<u>Clay (blue)</u>	<u>140</u>	<u>220</u>
<u>Sand</u>	<u>220</u>	<u>246</u>
<u>Blue clay</u>	<u>246</u>	<u>252</u>

WELL LOCATION: W/2, NE/4
sec. 32 T 1 N R 4 E
S W
5 miles SW of Mendenhall
(distance) (direction) (nearest town)

WELL PURPOSE: Home
(home, irrigation, municipal, industrial)

CODED


- WELL COMPLETION DATA:
- (1) diameter (inches) 4x2
 - (2) total depth (feet) 252
 - (3) static water level (feet) 80 below top of ground: above
 - (4) casing CI 209
(material) (depth)
4" If telescope see back.
(size)
 - (5) screen 1.0 236
(length) (depth to top)
2" S.S.
(size) (material)
 - (6) pump 2-Sub 15
(HP) (yield gpm)
Elec.
(type power)
 - (7) electric log yes
(yes or no)
Miss. G. Sur.
(organization running log)
 - (8) how well bottom plugged _____

JUL - 6 1968
MISS. BOARD OF
WATER COMMISSIONERS

DRILLERS REMARKS:

If well telescopes please sketch and show depths.

GROUND LEVEL

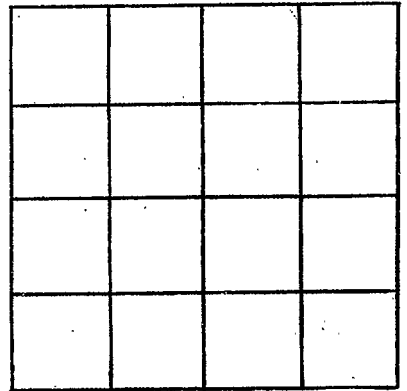

SECTION _____

Please indicate well location X.

ADDITIONAL INFORMATION

If more than one screen,
show locations of each on sketch.