

EL 70  
alt 450

Simpson  
J4  
4-67  
E-109

MISSISSIPPI  
BOARD OF WATER COMMISSIONERS  
416 North State Street  
Jackson, Mississippi 39201

CODED

WATER WELL DRILLERS LOG

4-13 1967 Water Well Dr. Co. Simpson  
date well completed firm name county well located

LANDOWNER: T.H. Morgan  
Mendenhall, Miss.

description of formations encountered	from to	
gravel	0	40
Blue clay	40	80
Fine sand	80	120
Blue clay	120	380
Coarse sand	380	440

(mailing address)

WELL LOCATION: NE, NW  
sec. 10 T 1 N R 4 E  
S W  
5 miles SW of Mendenhall  
(distance) (direction) (nearest town)

WELL PURPOSE: Home  
(home, irrigation, municipal, industrial)

WELL COMPLETION DATA:

- (1) diameter (inches) 4x2
- (2) total depth (feet) 440
- (3) static water level (feet) 60 <sup>below</sup> top of ground.
- (4) casing C.I. 134 (material) (depth)  
4" (size) If telescope see back.
- (5) screen 10 430 (length) (depth to top)  
2" 5, S. (size) (material)
- (6) pump 1 1/2 10 (HP) (yield gpm)  
Elec. (type power)
- (7) electric log Yes (yes or no)  
Miss. B. Sw. (organization running log)
- (8) how well bottom plugged


CODED

JUL 8 1968  
MISS. BOARD OF  
WATER COMMISSIONERS

DRILLERS REMARKS:

If well telescopes please sketch and show depths.

GROUND LEVEL

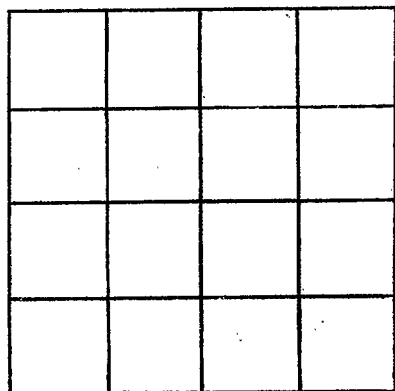

SECTION \_\_\_\_\_

Please indicate well location X.

ADDITIONAL INFORMATION

If more than one screen, show locations of each on sketch.