

**MISSISSIPPI
BOARD OF WATER COMMISSIONERS**
416 North State Street
Jackson, Mississippi 39201

CODED

WATER WELL DRILLERS LOG

Carloss

Simpson

December 15 19 67 TOWN OF MENDENHALL, MISSISSIPPI ??
date well completed firm name county well located

LANDOWNER:
Town of Mendenhall

(mailing address)

| description of formations encountered | from | to |
|---------------------------------------|------|------|
| Top Soil Clay | 0 | 8' |
| Coarse WB Sand | 8' | 23' |
| Rock | 23' | 25' |
| White Clay | 25' | 105' |
| Hard Gray Shale | 105' | 138' |
| Sandy Shale | 138' | 175' |
| Hard Shale | 175' | 228' |
| Sand | 228' | 233' |
| Hard Shale | 233' | 265' |
| Fine Sand | 265' | 299' |
| Grey Shale | 299' | 310' |
| Fine Hard Packed Sand | 310' | 343' |
| Sandy Clay | 343' | 410' |

WELL LOCATION:
sec. 3 T. 1 R. 4E
NW NE NE S R. W

(distance) miles (direction) of (nearest town)

WELL PURPOSE: Municipal
(home, irrigation, municipal, industrial)

WELL COMPLETION DATA:

(1) diameter (inches) 10"

(2) total depth (feet) 350 Feet

(3) static water level (feet) 95 below top of ground. below base

(4) casing Steel 261
(material) (depth)
10" if telescope see back.
(size)


(5) screen 72' 269
(length) (depth to top)
6" Stainless Steel
(size) (material)

(6) pump 15 342
(HP) (yield gpm)
Electric
(type power)

(7) electric log Yes
(yes or no)
USGS
(organization running log)

(8) how well bottom plugged BP
Valve

CODED

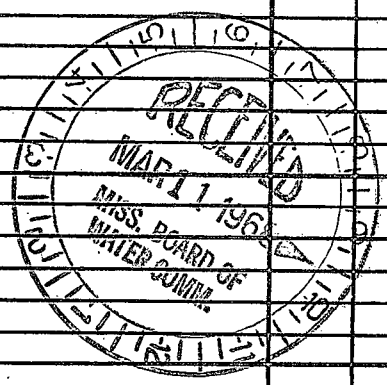

DRILLERS REMARKS:

NONE

