

SIMPSON MISSISSIPPI BOARD OF WATER COMMISSIONERS

WATER WELL DRILLERS LOG CODED

2  
6  
8-2-62

Date: 8/2, 1962, Driller: Wesley White County: Leflore  
(Name)

(1) Owner of Land: AA Farm

(Name)  
Mendenhall  
(Address)

Description & Color of Materials Sand, Clay, Red Clay, Shell, etc.	Thick- ness Feet	Depth Feet
<u>Red Clay</u>	<u>15</u>	<u>15</u>
<u>Sand</u>	<u>63</u>	<u>78</u>
<u>weather sand</u>	<u>9</u>	<u>87</u>

(2) Location: 1/4 34, 10 1962 Sec. TR

6 miles N of Mendenhall  
(distance) (direction) (Nearest Town)

(3) Topography: X (Hilly) (Flat) (Level)

(4) Purpose of Well:  
(Domestic Irrigation  
Municipal, Industrial, Other)

Information upon completion of well:


- (1) Diameter 2 inches.
- (2) Total Depth 87 feet.
- (3) Water Level 78 feet below top of ground.
- (4) Cased to 72, Size 2"
- (5) Screen: Size 1/4, Length 5.
- (6) Were any formations sealed against pollution?  
\_\_\_\_\_ yes, \_\_\_\_\_ no.

If YES depth of formation \_\_\_\_\_

Why \_\_\_\_\_

Drillers Remarks: \_\_\_\_\_

CODED

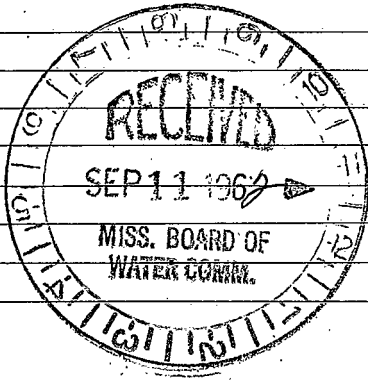

(Use Back Side)

Well No.

