

SIMPSON
 J10
 4-67

MISSISSIPPI
 BOARD OF WATER COMMISSIONERS
 416 North State Street
 Jackson, Mississippi 39201

CODED

WATER WELL DRILLERS LOG

April 1 1967 W.H. Dallas well for Simpson
 date well completed firm name county well located

LANDOWNER:
~~Jack Sullivan~~
 Weatherhead
 (mailing address)

description of formations encountered	from	to
	red clay	0
Chalk	10	100
Water sand	100	123

WELL LOCATION:
 sec. 12 T 1 N R 4 E
 S W
 1/2 miles S of Weatherhead
 (distance) (direction) (nearest town)

WELL PURPOSE:
 (home, irrigation, municipal, industrial)

WELL COMPLETION DATA:

(1) diameter (inches) 2 in

(2) total depth (feet) 123

(3) static water level (feet) 80 below above top of ground.

(4) casing NONE (material) (depth)
 if telescope see back.
 (size)

(5) screen 8 ft 43 (length) (depth to top)
 1 1/4 60 gpm. Brass (size) (material)

(6) pump 1/2 (HP) (yield gpm)
 (type power)

(7) electric log No (yes or no)
 (organization running log)


(8) how well bottom plugged

APR 4 1967
 MISS. BOARD OF
 WATER COMM.

DRILLERS REMARKS:

If well telescopes please sketch and show depths.

GROUND LEVEL

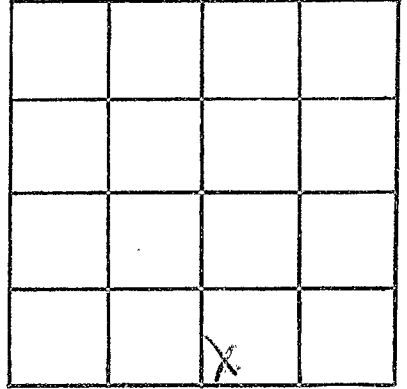

SECTION _____

Please indicate well location X.

ADDITIONAL INFORMATION

If more than one screen,
show locations of each on sketch.