

SIMPSON
 511
 - 68

MISSISSIPPI
 BOARD OF WATER COMMISSIONERS
 416 North State Street
 Jackson, Mississippi 39201

CODED

WATER WELL DRILLERS LOG

19 7-5 Simpson Simpson
 date well completed firm name county well located


LANDOWNER:	description of formations encountered	from	to
<i>H. B. Smith</i> <i>Mendenhall Miss. 39114</i> (mailing address)			
WELL LOCATION: sec. <u>15</u> T. <u>1</u> N. R. <u>4</u> E. (distance) miles of <u>Mendenhall</u> (direction) (nearest town)	<i>hard clay</i>	<u>0</u>	<u>5</u>
	<i>sand</i>	<u>5</u>	<u>45</u>
	<i>hard sand</i>	<u>45</u>	<u>63</u>
	<i>river rock</i>	<u>63</u>	<u>64</u>
WELL PURPOSE: <u>farm</u> (home, irrigation, municipal, industrial)	<i>high clay</i>	<u>64</u>	<u>120</u>
WELL COMPLETION DATA:	<i>shale</i>	<u>120</u>	<u>136</u>
(1) diameter (inches) <u>2"</u>	<i>sand</i>	<u>136</u>	<u>168 1/2</u>
(2) total depth (feet) <u>172"</u>	<i>rock</i>	<u>168 1/2</u>	<u>167</u>
(3) static water level (feet) <u>109'</u> below above top of ground.	<i>blue clay</i>	<u>167</u>	<u>172</u>
(4) casing <u>Gal.</u> <u>162'</u> (material) (depth)			
<u>3"</u> (size) if telescope see back.			
(5) screen <u>6'</u> <u>162'</u> (length) (depth to top)			
<u>2"</u> <u>Plastic</u> (size) (material)			
(6) pump <u>1 1/2</u> <u></u> (HP) (yield gpm)			
<u>PL</u> (type power)			
(7) electric log <u>none</u> (yes or no)			
<u>Miss. D. S.</u> (organization running log)			
(8) how well bottom plugged <u>open</u>			
DRILLERS REMARKS:			

CODED

JUN 1 1968
 MISS. BOARD OF
 WATER COMMISSIONERS

If well telescopes please sketch and show depths.

GROUND LEVEL

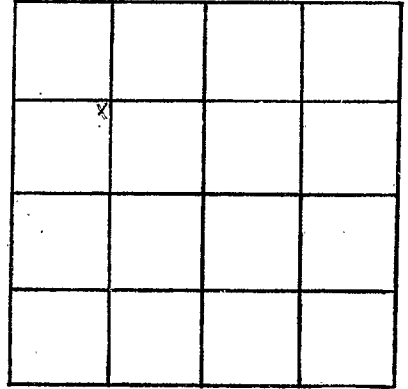

SECTION 15

Please indicate well location X.

ADDITIONAL INFORMATION

If more than one screen,
show locations of each on sketch.