

MISSISSIPPI BOARD OF WATER COMMISSIONERS

SIMPSON
J13
12-7-60

WATER WELL DRILLERS LOG

CODED
J-301

Date: 12/7, 1960, Driller: James A. White County Simpson
(Name)

(1) Owner of Land: SE Moyer
(Name)
Rt 3 Mendenhall
(Address)

(2) Location: SE 1/4, SW 1/4, Sec 20 T14 R1E
5 miles NE SW of Mendenhall
(distance) (direction) (Nearest Town)

(3) Topography: (Flat) (Level)

(4) Purpose of Well: Domestic
(Domestic Irrigation
Municipal, Industrial, Other)

Description & Color of Materials Sand, Clay, Red Clay, Shell, etc.	Thick- ness Feet	Depth Feet
Red Clay	10	10
white chalk	20	30
Red Shell	75	105
Sand	5	110

Information upon completion of well:

(1) Diameter 2 inches.

(2) Total Depth 110 feet.

(3) Water Level 30 feet below top of ground.

(4) Cased to 82, Size 2"


(5) Screen: Size open, Length

(6) Were any formations sealed against pollution?
_____ yes, _____ no.

If YES depth of formation

Why

Drillers Remarks:

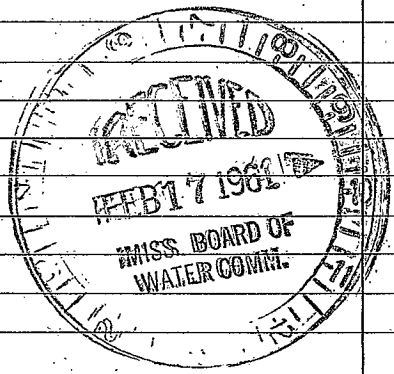

(Use Back Side)

Well No.

[The text in this image is extremely faint and illegible due to low contrast and scan quality. It appears to be a multi-paragraph document with some headings and possibly a list or table of contents, but no specific words or numbers can be discerned.]