

J/6  
3-31-62

WATER WELL DRILLERS LOG

# 76  
CODED

Date: 3/31, 1962, Driller: Wagel Robert County Singer  
(Name)


- (1) Owner of Land: Fruitt May  
(Name)  
Mendenhall, Miss  
(Address)
- (2) Location: 1/4, 1/4, Sec. 6 T14R5E  
3 miles W, of Mendenhall  
(distance) (direction) (Nearest Town)
- (3) Topography: X  
(Hilly) (Flat) (Level)
- (4) Purpose of Well: Domestic  
(Domestic Irrigation  
Municipal, Industrial, Other)

Description & Color of Materials Sand, Clay, Red Clay, Shell, etc.	Thick- ness Feet	Depth Feet
<u>red clay</u>	<u>15</u>	<u>15</u>
<u>sand &amp; gravel</u>	<u>63</u>	<u>78</u>
<u>water sand</u>	<u>12</u>	<u>90</u>

Information upon completion of well:

- (1) Diameter 2 inches.
- (2) Total Depth 90 feet.
- (3) Water Level 78 feet below top of ground.
- (4) Cased to 85, Size 2"
- (5) Screen: Size 1/4, Length 5 ft
- (6) Were any formations sealed against pollution?  
\_\_\_\_\_ yes, \_\_\_\_\_ no.

If YES depth of formation \_\_\_\_\_  
Why \_\_\_\_\_  
Drillers Remarks: \_\_\_\_\_

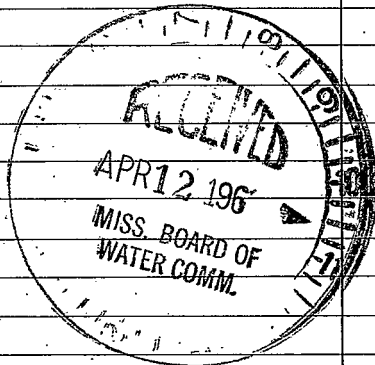

(Use Back Side)

Well No.

