

SIMPSON
 J 17
 8-3-62

WATER WELL DRILLERS LOG


Date: 8/3, 1962, Driller: George White County Desha
 (Name)

(1) Owner of Land:	Description & Color of Materials Sand, Clay, Red Clay, Shell, etc.	Thick- ness Feet	Depth Feet
(Name) <u>Mr. & Mrs. J. J. Jendry</u>	<u>Red Clay</u>	<u>15</u>	<u>15</u>
(Address) <u>Mendenhall, Miss</u>	<u>red clay</u>	<u>12</u>	<u>27</u>
(2) Location: <u>1/4</u> , <u>1/4</u> , Sec. <u>20</u> T <u>1</u> R <u>4</u>	<u>Sand</u>	<u>8</u>	<u>35</u>
(<u>1</u> miles <u>5</u> mi of <u>Meritt</u>) (distance) (direction) (Nearest Town)			
(3) Topography: <u>X</u> (Hilly) (Flat) (Level)			
(4) Purpose of Well: <u>Domestic</u> (Domestic Irrigation Municipal, Industrial, Other)			

Information upon completion of well:

- (1) Diameter 2" inches.
- (2) Total Depth 35 ft feet.
- (3) Water Level 27 feet below top of ground.
- (4) Cased to _____, Size _____
- (5) Screen: Size 1/4, Length 5 ft
- (6) Were any formations sealed against pollution?
 _____ yes, _____ no.

If YES depth of formation _____
 Why _____
 Drillers Remarks: _____

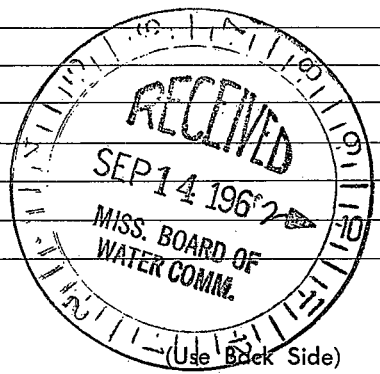

Well No.

