

J 18

8-4-62

WATER WELL DRILLERS LOG

Date: 8/4, 1962, Driller: Raymond White County Simpson
(Name)

(1) Owner of Land: <u>David Brant</u> (Name) <u>Mendenhall, Miss</u> (Address)	Description & Color of Material Sand, Clay, Red Clay, Shell, etc.	Thickness Feet	Depth Feet
(2) Location: _____ 1/4, _____ 1/4, Sec. <u>9</u> T. <u>1</u> R. <u>4</u> <u>1/2</u> miles <u>N</u> of <u>Warrent</u> (distance) (direction) (Nearest Town)			
(3) Topography: _____ (Hilly) (Flat) (Level)			
(4) Purpose of Well: <u>Domestic</u> (Domestic Irrigation Municipal, Industrial, Other)			


Information upon completion of well:

- (1) Diameter 2" inches.
- (2) Total Depth 33 feet.
- (3) Water Level 12 feet below top of ground.
- (4) Cased to _____, Size _____
- (5) Screen: Size 1 1/2, Length 5 ft
- (6) Were any formations sealed against pollution?
 _____ yes, _____ no.

If YES depth of formation _____

Why _____

Drillers Remarks: _____

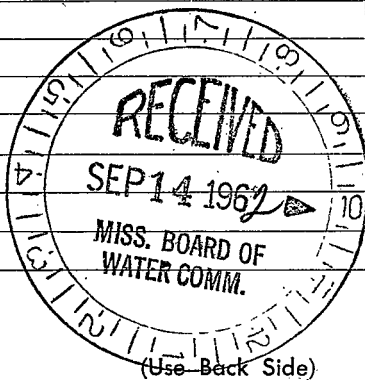

Well No.

