

MISSISSIPPI
BOARD OF WATER COMMISSIONERS **CODED**
416 North State Street
Jackson, Mississippi 39201

WATER WELL DRILLERS LOG

Simpson
J 25
7-69

July 21 1969 W.G. Butler SIMPSON
date well completed firm name county well located

LANDOWNER:

Frank Shotts
Mendonhall
(mailing address)

WELL LOCATION:

sec. 4 T. 10 N. R. 4 E
S. W.
3/4 miles S of Mendonhall
(distance) (direction) (nearest town)

WELL PURPOSE: Home
(home, irrigation, municipal, industrial)

WELL COMPLETION DATA:

- (1) diameter (inches) 2"
- (2) total depth (feet) 366
- (3) static water level (feet) 105 below above top of ground.
- (4) casing galv, 336,
(material) (depth)
2" if telescope see back.
(size)
- (5) screen 9', 336
(length) (depth to top)
2", SS
(size) (material)
- (6) pump 1, 26
(HP) (yield gpm)
Electric
(type power)
- (7) electric log No
(yes or no)

(organization running log)

(8) how well bottom plugged 2" RW

description of formations encountered

from to

Clay + Rock	0	30
Clay (Rock + Sand)	30	40
Rock + Clay	40	50
Clay + Sand	50	65
Sand	65	70
Sand + Clay	70	80
Clay + Rock	80	90
Clay	90	100
Clay + Sand	100	150
Clay + Rock	150	155
Sand + Clay	155	180
Rock + Clay	180	222
Rock	222	232
Rock + Clay	232	243
Rock	243	264
Rock + Clay	264	285
Sand Clay Rock	285	306
Rock	306	327
Sand	327	366


DRILLERS REMARKS:

THIS IS OF
WATER BOARD

MIC 4 1969

If well telescopes please sketch and show depths.

GROUND LEVEL

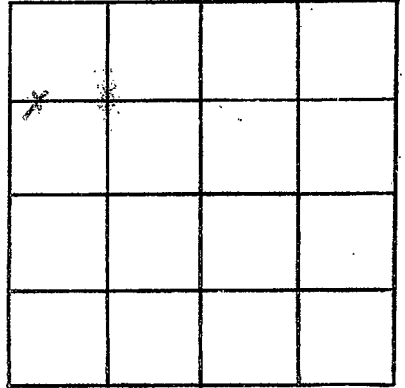

SECTION 4

Please indicate well location X.

ADDITIONAL INFORMATION

If more than one screen,
show locations of each on sketch.