

Simpson
J 26,
12-29-69

MISSISSIPPI
 BOARD OF WATER COMMISSIONERS
 416 North State Street
 Jackson, Mississippi 39201

CODED

WATER WELL DRILLERS LOG

Dec 29 1969 W.P. Thompson Well Simpson
 date well completed firm name county well located

LANDOWNER:	description of formations encountered	from	to
<u>James Smith</u> <u>Mendenhall Miss</u> (mailing address)			
WELL LOCATION:	<u>sand</u>	<u>25</u>	<u>90</u>
sec. <u>34</u> T. <u>1</u> N. R. <u>20</u> W.	<u>sand</u>	<u>90</u>	<u>125</u>
<u>6</u> miles <u>8</u> of <u>Mendenhall</u>	<u>sand</u>	<u>125</u>	<u>140</u>
(distance) (direction) (nearest town)			
WELL PURPOSE: <u>home</u> (home, irrigation, municipal, industrial)			
WELL COMPLETION DATA:			
(1) diameter (inches) <u>2"</u>			
(2) total depth (feet) <u>140'</u>			
(3) static water level (feet) <u>94</u> below above top of ground.			
(4) casing <u>galv</u> , <u>128'</u> (material) (depth)			
<u>2"</u> (size) if telescope see back.			
(5) screen <u>10'</u> , <u>128'</u> (length) (depth to top)			
<u>2"</u> , <u>plastic</u> (size) (material)			
(6) pump <u>1/2</u> , <u>4</u> (HP) (yield gpm)			
<u>Road Runner</u> (type power)			
(7) electric log <u>no</u> (yes or no)			
(organization running log)			
(8) how well bottom plugged <u>plugged</u>			


JAN - 7 1970

DRILLERS REMARKS:

MISS. DEP. OF
 WATER COMM.

If well telescopes please sketch and show depths.

GROUND LEVEL

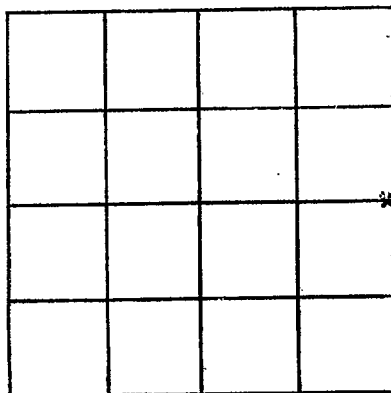

SECTION 34

Please indicate well location X.

ADDITIONAL INFORMATION

If more than one screen,
show locations of each on sketch.