

Simpson  
 J 27  
 11-15-69

**CODED**

MISSISSIPPI  
 BOARD OF WATER COMMISSIONERS  
 416 North State Street  
 Jackson, Mississippi 39201

**WATER WELL DRILLERS LOG**

11-15-69 19 Jack Perley Waterwell Drilling Service Simpson  
 date well completed firm name county well located

LANDOWNER: Jerry L. Patton  
Rt. 2, Box 100-C  
Mendenhall, Miss  
 (mailing address)

description of formations encountered	from	to
	CHALK	0
SAND	60	70
CHALK	70	300
SAND	300	318

WELL LOCATION:  
 sec. 10 T. 1 N. R. 4 W.  
6 miles S of MENDENHALL  
 (distance) (direction) (nearest town)

WELL PURPOSE: none  
 (home, irrigation, municipal, industrial)

- WELL COMPLETION DATA:
- diameter (inches) 2 inches
  - total depth (feet) 318 feet
  - static water level (feet) 100 below above top of ground.
  - casing galvanized 318  
 (material) (depth)  
 (size) if telescope see back.
  - screen 4 ft. 3/4  
 (length) (depth to top)  
2 inch standard steel  
 (size) (material)
  - pump 3/4 310  
 (HP) (yield gpm)  
Electric  
 (type power)
  - electric log \_\_\_\_\_  
 (yes or no)  
 (organization running log)
  - how well bottom plugged BWV

**CODED**


MAR 16 1970  
 1970

MISS. BD. OF  
 WATER COMM.

DRILLERS REMARKS:

If well telescopes please sketch and show depths.

GROUND LEVEL

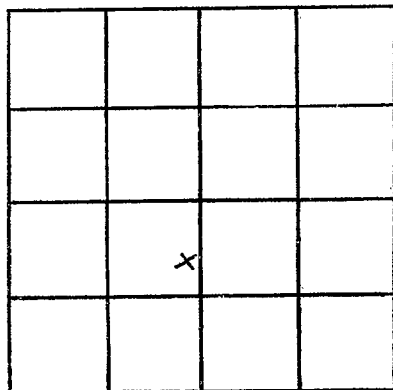

SECTION 10

Please indicate well location X.

ADDITIONAL INFORMATION

If more than one screen, show locations of each on sketch.