

SIMPSON

J 31

8-24-70

MISSISSIPPI BOARD OF WATER COMMISSIONERS 416 North State Street Jackson, Mississippi 39201

CODED

WATER WELL DRILLERS LOG

aug 24

1970

R. E. Thompson Well Simpson

date well completed

firm name

county well located

LANDOWNER:

San Henderson

description of formations encountered

from

to

Jackson Miss (mailing address)

top soil

10 10

sand

10 22

WELL LOCATION:

sec. 8 T. 1 N R. 4 E

B. clay

22 50

1.4 miles S of Monticello (distance) (direction) (nearest town)

fine sand

50 64

WELL PURPOSE: (home, irrigation, municipal, industrial)

B. clay

64 226

sand

226 238

WELL COMPLETION DATA:

- (1) diameter (inches) 2 1/2"
(2) total depth (feet) 250'
(3) static water level (feet) 100 below top of ground.
(4) casing 2 1/2" (material) (depth)
(5) screen 10' (length) 225' (depth to top)
(6) pump 3/4 HP 20 (yield gpm)
(7) electric log yes
(8) how well bottom plugged

B. clay

238 250

CODED


AUG 25 1970

DRILLERS REMARKS:

MISS. BD. OF WATER COMM.

If well telescopes please sketch and show depths.

GROUND LEVEL

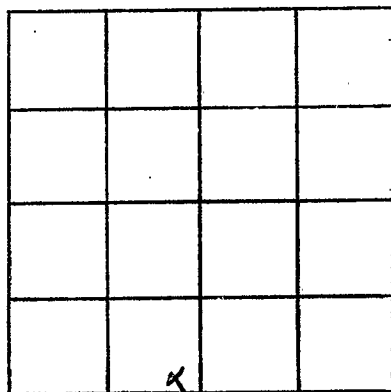

SECTION 8

Please indicate well location X.

ADDITIONAL INFORMATION

If more than one screen,  
show locations of each on sketch.